


CERTIFIED RECORD OF LAND CORNER MONUMENTATION

History of original corner establishment:

Corner established in 1895 by General Land Office
Resurveyed in 1899 - Contract Survey

Original Survey record states: The corner established on former survey (1895) which is a fir post 3 ft. long, 4 ins. sq., set 24 ins. in the ground. Marked T19S S.25 on N.E., R10W S.36 on S.E., S.35 on S.W. and S.26 on N.W. faces: with 1 notch on the S. & E. edges. from which:

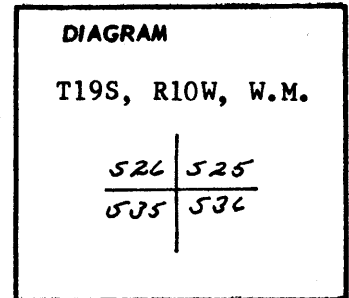

- An alder 5 ins. diam. bears N 77° E 19 lks. dist. Marked T19S R10W S. 25 B.T.
- A hemlock 6 ins. diam. bears S 5° E 23 lks. dist. Marked T19S R10W S. 36 B.T.
- A vine maple 6 ins. diam bears S 43° W 8 lks. dist. Marked T19S R10W S. 35 B.T.
- A hemlock 15' ins. diam. bears N 28° W 48 lks. dist. Marked T19S, R10W S 26 B.T.

Description of corner evidence found:

Found an old blazed line running South from the North Fork Smith River and another running East from the River. We determined this to be the original section line blazes by chopping out several blazes and finding them to be 70 to 75 years old, which dates back to the original survey. Other blazes were as recent as 50 years old. The calls on the river to the North and West and a ridge to the East were checked and found to agree well with the G.L.O. calls from the intersection of the blazed lines.


No original bearing trees were found.

Double proportion would place this corner approximately 190 feet North and 5-600 feet West of the river versus the calls of 660 feet South and 858 feet East or grossly out of position. Hence the blaze intersection was used for positioning the corner.

Description of monument and accessories I established to perpetuate the original location of this corner

At the intersection of blazed lines I set a 2" X 36" galvanized iron pipe, flanged at the bottom and capped with a bronze disk welded on top. The monument projects 6" above the ground. I filled in around the pipe monument with stone and packed earth.

I stamped the disk

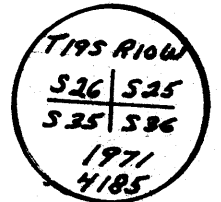

I established new bearing trees as follows. Each bearing tree has a scribed face and a U.S.F.S. bearing tree tag breast high and facing the monument.

Bearing trees set:

- a 20" D. Fir bears N 6° E 30.7 feet
- a 32" D. Fir bears N 13° W 33.1 feet
- a 22" D. Fir bears S 50° W 53.90 feet
- a 26" D. Fir bears S 68° E 21.0 feet

Office of County Surveyor County of Douglas
State of Oregon , I hereby certify that the within instrument was filed in this office
for record on the 4 day of AUGUST, 1971, at 2 o'clock P.m., (signed)
James W. Ryerson by
(COUNTY OFFICIAL) (DEPUTY)

James W. Ryerson