

FILED  
RECEIVED



Weyerhaeuser Company

Section 2

Township 27 S


Range 8 W, W.M.

Douglas Co., Ore.

AUG 23 1971

COUNTY SURVEYOR  
DOUGLAS COUNTY, ORE.

RESTORED CORNER FOR WEYERHAEUSER COMPANY

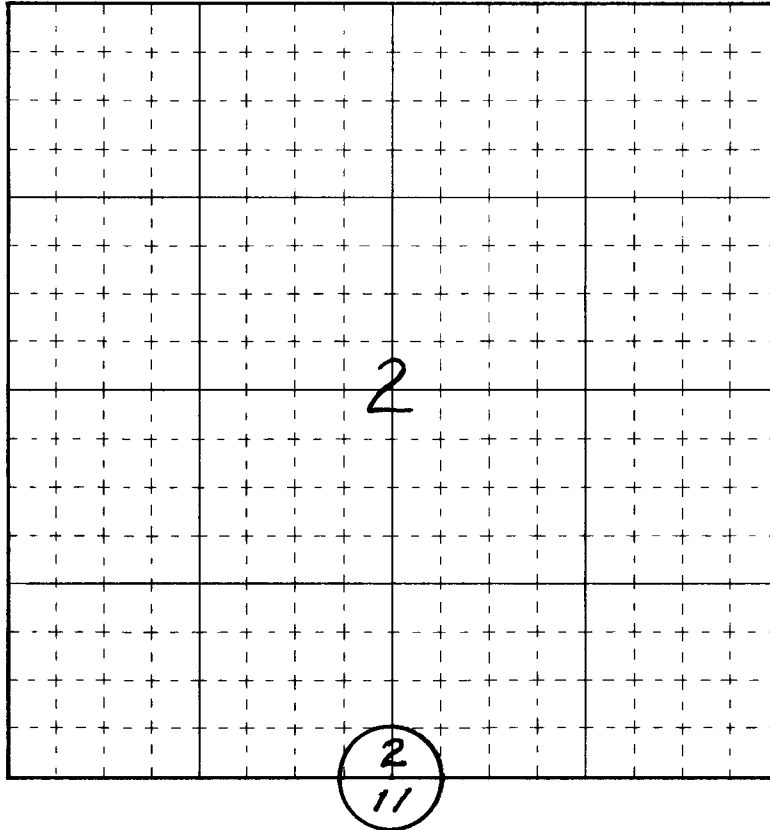

REGISTERED  
OREGON  
LAND SURVEYOR

*Craig L. Templin*

JULY 17, 1970  
CRAIG L. TEMPLIN  
938

Original:

Post (found point of rotted post ) from which:  
 10" cedar bears N 72° W 51 lks. (missing)  
 12" cedar bears S 76° W 34 lks. ( a cedar present, but  
 no evidence of face or scribing)

Restored:

Set a 1 1/2" Iron pipe with Brass Cap marked " 1/4 S II <sup>2</sup> BT"  
 6" fir bears N 70° W 4.8 ft. marked 1/4 S BT - tag, "W" nail  
 6" fir bears S 31 1/2° W 9.2 ft. marked 1/4 S BT - tag, "W" nail

Transit survey was run from the SW cor. to the SE cor. of this section  
 and the position for the 1/4 cor. was calculated. The post was found  
 4.5 ft. N 34° W of the calculated position.

June 17 1971  
 Craig Templin, Party Chief  
 H. A. Lester, Instrumentman  
 J.W. McWhorter, Chainman

O.K.  
J.W.B.