


**COUNTY SURVEYORS FILE DATA**  
**DO NOT REMOVE FROM OFFICE**

*SURVEY FOR DEED DESCRIPTIONS*  
*IN SEC. 7, T.29S., R.7W. W.M.*  
*FOR RUSSELL & STRINGER*  
*by BRUCE ROGERS*  
*DEC., 1971*  
*1" = 100'*



FILED *LR*  
 RECEIVED

DEC 16 1971

COUNTY SURVEYOR  
 DOUGLAS COUNTY, ORE.

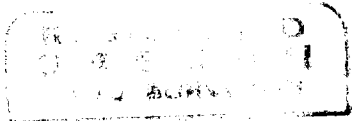

*Bruce R. Rogers*

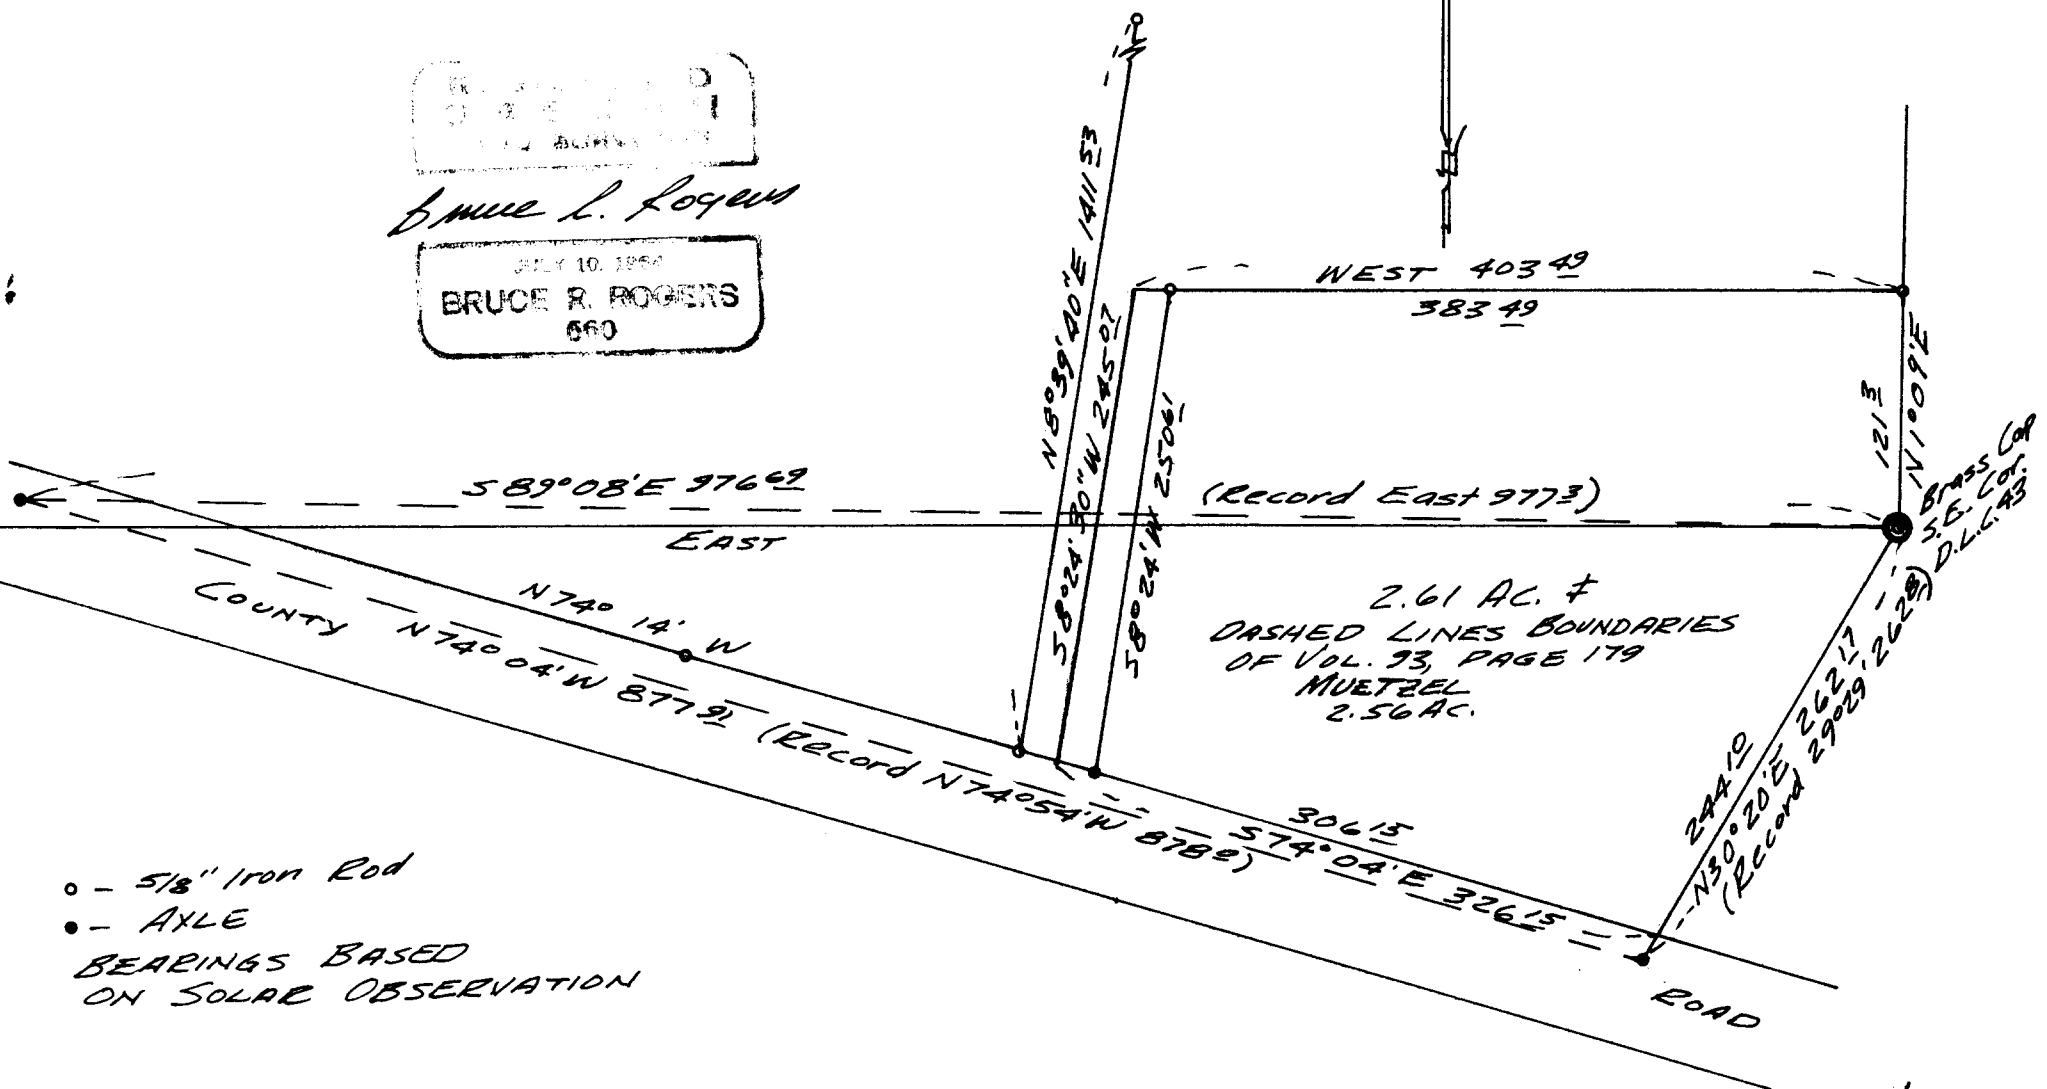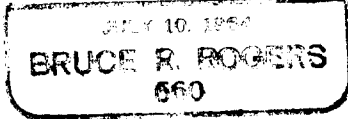

- - 5/8" Iron Rod
  - - AXLE
- BEARINGS BASED  
 ON SOLAR OBSERVATION