

COUNTY SURVEYORS FILE DATA
DO NOT REMOVE FROM OFFICE


SURVEY FOR DEED DESCRIPTION
IN SEC. 20, T. 25S., R. 5W. W.M.
FOR BUD SCHOON
by BRUCE ROGERS
DEC., 1971
1" = 50'

SE. COR. TRACT 6
COOKS ORCHARD
TRACTS

FILED
RECEIVED

JAN 3 1972.

COUNTY SURVEYOR
DOUGLAS COUNTY, ORE.

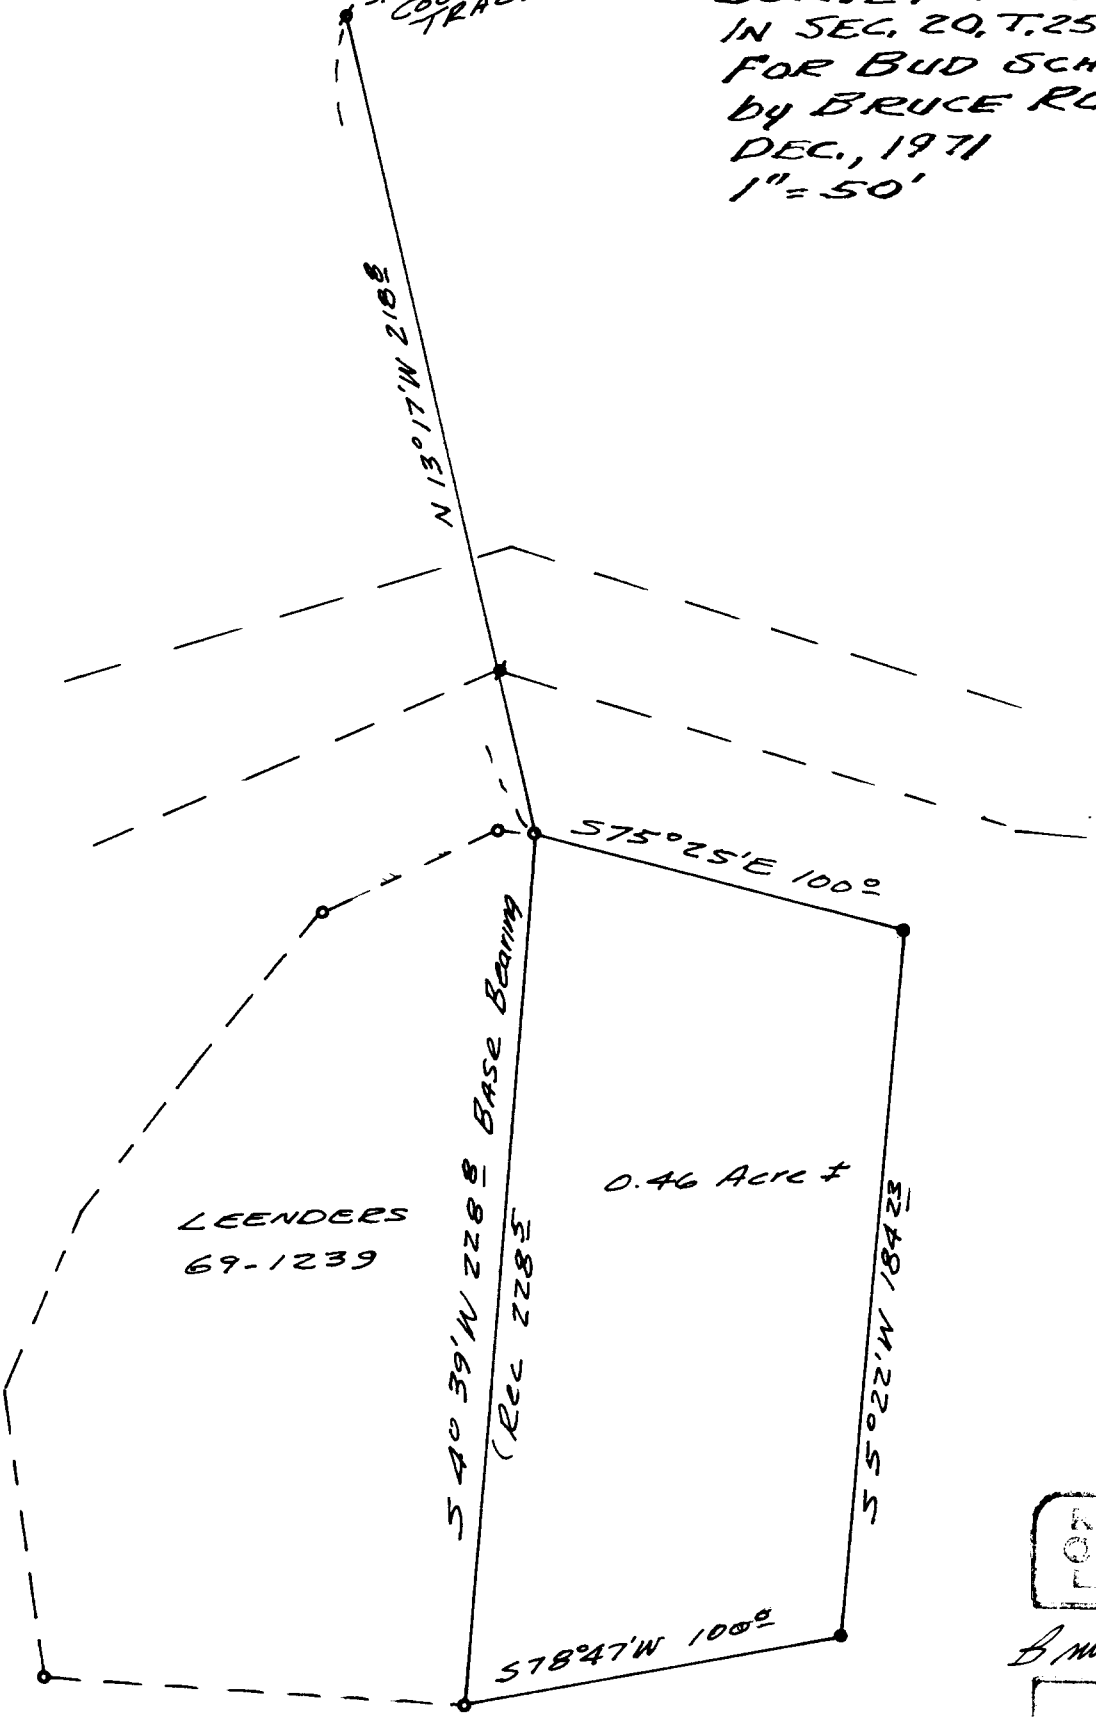

- - FOUND 1/2" Iron Pipe
- ⊕ - FOUND Iron Rod
- - SET 5/8" Iron Rod

REGISTERED
OREGON
LAND SURVEYOR

Bruce L. Rogers

JAN 10 1972
BRUCE R. ROGERS
650