

SURVEY FOR DEED DESCRIPTION
 IN SECTION 12, T. 29 S., R. 6 W. W.M
 FOR ALVIN HELGESEN
 by BRUCE ROGERS


JAN., 1972
 1" = 200'

FILED
 RECEIVED

JAN 5 1972.

COUNTY SURVEYOR
 DOUGLAS COUNTY, ORE.

COUNTY SURVEYORS FILE DATA
 DO NOT REMOVE FROM OFFICE

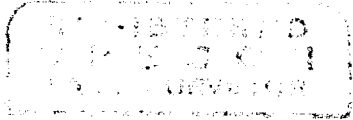

Bruce L. Rogers

