

RESTORED CORNER FOR STATE OF OREGON--DEPARTMENT OF FORESTRY

One quarter corner for Section 16 (West side), T22S, R10W, W.M., Douglas County, Oregon.

ORIGINAL

Stone (missing) from which a:

- 5" Maple bears N60°W 65lks.; now missing, clump of small maples in place.
- 6" Fir bears N35°E 55 lks.; now 36" windfall, scribe T visible.

RESTORED

Set 1 1/2" x 36" galvanized iron pipe with 3" bronze cap marked "OREGON STATE BOARD OF FORESTRY 1/4 S16 1971 RS 359", 34 inches in ground, and from which a:


- 26" Fir bears N25°W 17.6 ft. to face; scribed 1/4 S17 BT.
- 22" Fir bears N69 1/2°E 14.3 ft. to face; scribed 1/4 S16 BT RS 359.

Set 4" x 4" x 72" white painted Cedar post 2.0 ft. North of corner pipe. Oregon State Forestry Department metal location poster on 26" Fir BT N25°W 17.6 ft.

Dated May 30, 1972

Restored by Charles W. Cook under my direction.
Charles W. Cook, Engineer

Present and witnessed by Kenneth L. Graham
Dale E. Redding

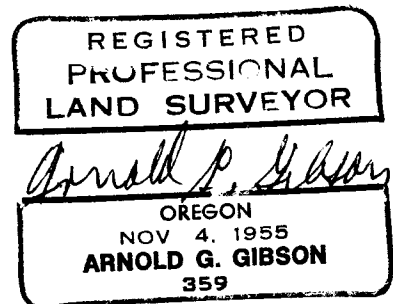

#64 ✓