

RESTORED CORNER FOR STATE OF OREGON-DEPARTMENT OF FORESTRY

Section corner for Section 17 (Northeast), Township 22 South, Range 10 West, W.M., Douglas County, Oregon.

ORIGINAL

20" x 16" x 8" Sandstone (missing) from which a:

- 28" Fir bears N10°E 20 lks.; missing.
- 20" Fir bears S31°E 30 lks.; missing.
- 36" Fir bears N89°W 3 lks.; now missing.
- Ridgetop bears West 2.50 ch.; in place.
- Northwest corner Section 16 bears S00°03' 1.35 ch.; OSBF pipe and cap in place, 1 original BT, 1 new BT.

RESTORED

Set 1 1/2" x 36" galvanized iron pipe with 3" bronze cap marked "OREGON STATE BOARD OF FORESTRY T22S R10W S17 S8 S16 1971 RS359", 34 inches in ground, and from which a:


- 18" Fir bears N79°W 27.4 ft. to face; scribed T22S R10W S17 BT RS359.
- 2' high x 8' long rock face bears S30 1/2°W 3.5 ft. to face; scribed XBO.

Set 4" x 4" x 72" white painted Cedar post 3.6 ft. S12°E of corner pipe. Oregon State Forestry Department metal location poster on 18" Fir BT N79°W 27.4 ft.

Dated July 20, 1972

Restored by Charles W. Cook under my direction.

Present and witnessed by Steven A. Nicholson
William E. Metcalf
John E. Hook

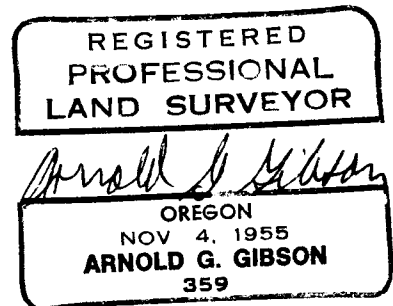

FILED
RECEIVED

AUG 16 1972

COUNTY SURVEYOR
DOUGLAS COUNTY, OREGON

C. S. File No. 55/233-4

#63 ✓