

RESTORED CORNER FOR STATE OF OREGON--DEPARTMENT OF FORESTRY

Section corner common to Sections 25 and 36 (East end), T22S, R11W, W.M., Douglas County, Oregon.

ORIGINAL

18" x 12" x 18" Stone (missing) from which a:

- 60" Burnt Fir bears S59°W 167 lks.; now 60" snag, in place, scribes T23S R11W 36 visible.
- 10" Alder bears N41°W 36 lks.; missing, in slide out.

RESTORED


Set 1 1/2" x 36" galvanized iron pipe with 3" bronze cap marked "OREGON STATE BOARD OF FORESTRY T22S S25 S36 R11W T22S S31 R10W 1971 RS 359", 34 inches in ground, in mound of rock, and from which a:

- 19" Fir bears N41°W 69.0 ft. to face; scribed T22S R11W S25 BT RS 359.
- 35" Fir bears West 100.8 ft. to face; scribed T22S R11W S36 BT.

Set 4" x 4" x 72" white painted Cedar post 3.0 ft. N50°W of corner pipe. Oregon State Forestry Department metal location poster on 19" Fir BT N41°W 69.0 ft.

Dated May 30, 1972

Restored by Charles W. Cook under my direction.
Charles W. Cook, Engineer

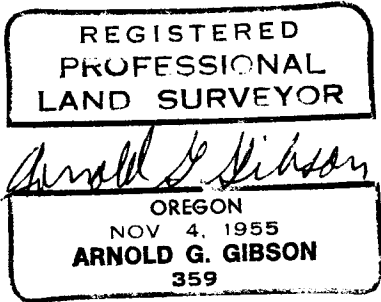

Present and witnessed by Dale E. Redding
Kenneth L. Graham
William A. Bodewig

*1966 7/22/72 ✓
1972 5/30/72 ✓*

FILED
RECEIVED

AUG 16 1972

COUNTY SURVEYOR
DOUGLAS COUNTY, ORE.