

RESTORED CORNER FOR STATE OF OREGON--DEPARTMENT OF FORESTRY

One quarter corner common to Sections 35 and 36, T22S, R11W, W.M., Douglas County, Oregon.

ORIGINAL

Post (missing) from which a:

20" Fir bears N56°W 22 lks.; now 27" freshly cut stump, scribes 1/ visible.

10" Alder bears N78°E 13 lks.; missing.

RESTORED

Set 1 1/2" x 36" galvanized iron pipe with 3" bronze cap marked "OREGON STATE BOARD OF FORESTRY 1/4 S35 S36 1971 RS 359", 34 inches in ground, in side draw (course N30°W), and from which a:


4' wide rock draw course N30°W, bears S33 1/2°E 8.0 ft.; chiseled 6" x 80.

4' high x 20' rock face bears N54 1/4°W 44.6 ft.; chiseled 6" x 80.

Set 4" x 4" x 72" white painted Cedar post 4.3 ft. S84°E of corner pipe. Oregon State Forestry Department metal location poster on 24" Fir stump (orig. BT) N56°W 13.4 ft. Also poster on 4' high x 20 ft. rock face N54 1/4°W 44.6 ft.

Dated May 30, 1972

Restored by Charles W. Cook under my direction.
Charles W. Cook, Engineer

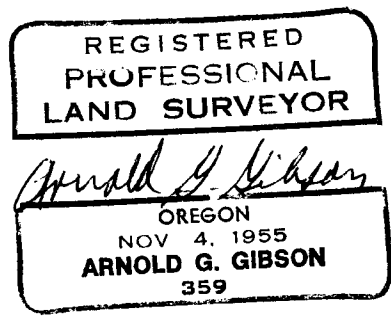

Present and witnessed by Kenneth L. Graham
William A. Bodewig

FILED
RECEIVED

AUG 16 1972

COUNTY SURVEYOR
DOUGLAS COUNTY, ORE.