

RESTORED CORNER FOR STATE OF OREGON--DEPARTMENT OF FORESTRY

One quarter corner for Section 36 (East side), Township 22 South, Range 11 West, W.M., Douglas County, Oregon.

ORIGINAL

Stone 20" x 14" x 10" (missing) from which a:

- 5" Fir bears N87°W 11 lks.; missing.
- 40" Burnt Fir bears N81°E 32 lks.; in place, scribes 1/4 S BT visible.

RESTORED


Set 1½" x 36" galvanized iron pipe with 3" bronze cap marked "OREGON STATE BOARD OF FORESTRY 1/4 S36 1971 RS359", 34 inches in ground, and from which a:

- 39" Fir bears N53°W 31.0 ft. to face; scribed 1/4 S36 BT RS359.
- 32" Fir bears S54½°W 86.8 ft. to face; scribed 1/4 S36 BT.

Set 4" x 4" x 72" white painted Cedar post 1.2 ft. N55°W of corner pipe. Oregon State Forestry Department metal location poster on 32" Fir BT.

Dated October 12, 1971

Restored by Charles W. Cook under my direction.
Charles W. Cook, Engineer

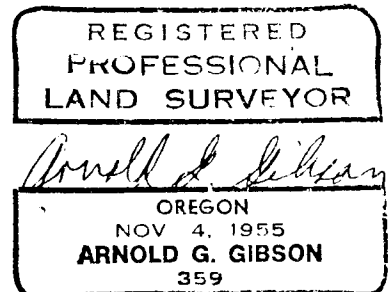

Present and witnessed by Dale E. Redding
William A. Bodewig

FILED
RECEIVED

FEB 3 1972

COUNTY SURVEYOR
DOUGLAS COUNTY, ORE.

117 T 22-11
58 T 22-10

SEE M 45-3

U. S. File No. 55/233-11