

# SURVEY TO SET PROPERTY CORNERS

For: DALLAS HORN

LOT 1, BLOCK 1, MOUNTAIN VIEW SEC. 14, T27S, R6W, W.M.

By: BAUGHMAN SURVEYING SERVICE

SEPTEMBER 1972

COUNTY SURVEYORS FILE DATA  
DO NOT REMOVE FROM OFFICE

REGISTERED  
PROFESSIONAL  
LAND SURVEYOR

*Glenn S. Baughman*

OREGON  
JULY 14, 1921  
GLENN S. BAUGHMAN  
536

NE COR  
LOT 4 Fd.I.P.


FILED  
RECEIVED

SEP 26 1972

COUNTY SURVEYOR  
DOUGLAS COUNTY, ORE.



SCALE: 1"=30'

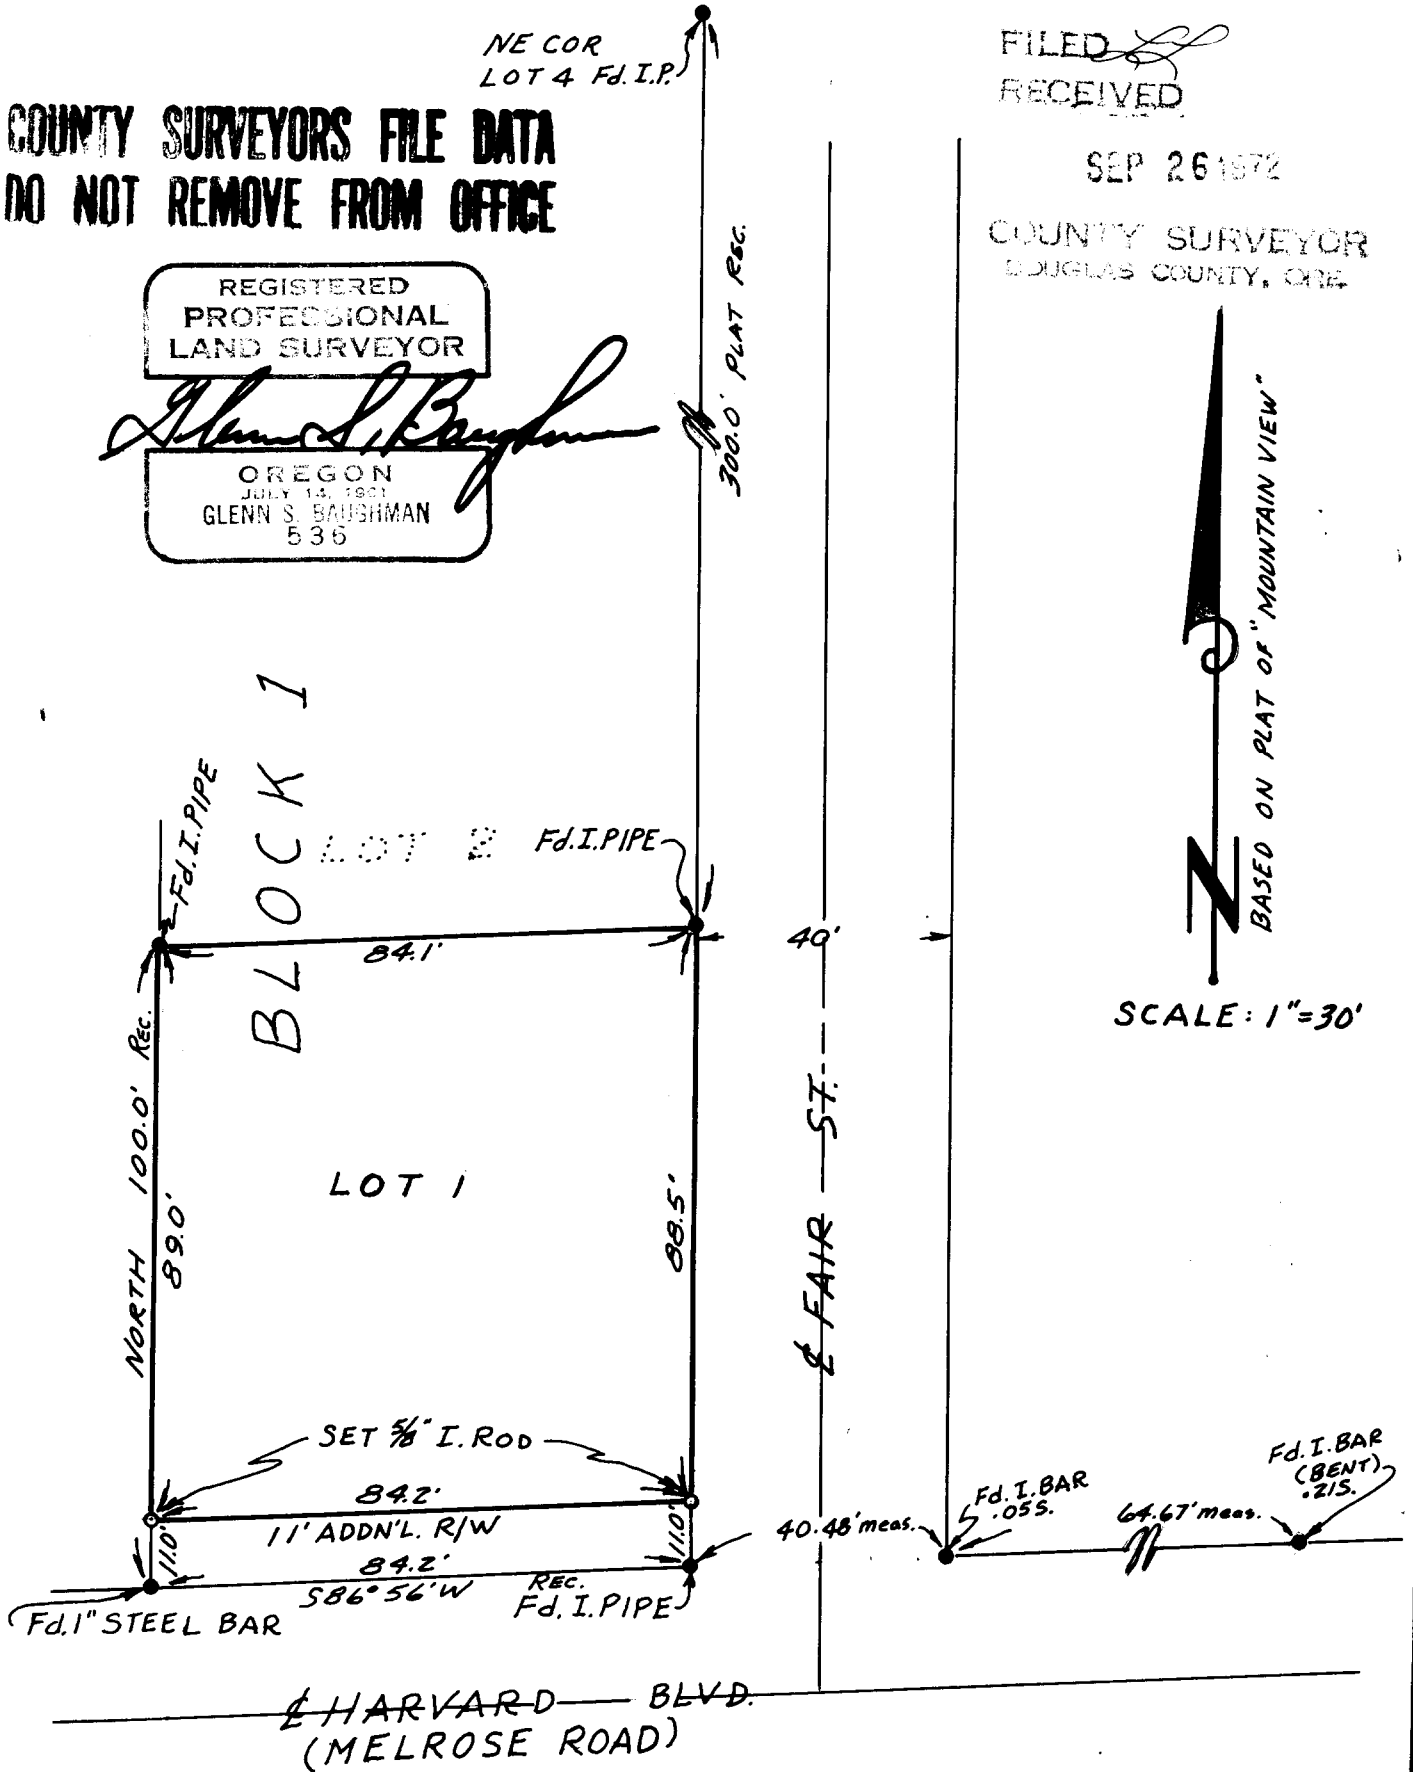

EAB