



PROPERTY SURVEY

LOTS 2 AND 3, BLOCK 4
 UMPQUA ADDITION
 REEDSPORT, OREGON
 SCALE: 1" = 30' 2-19-72

FOR: WILLIAM JAYNE
 RE: JAMES DEWITT

ALL IRON PIPES SET - 3/4"

BEARINGS BASED ON THE PLAT
 OF UMPQUA ADDITION TO
 REEDSPORT, DOUGLAS COUNTY,
 OREGON

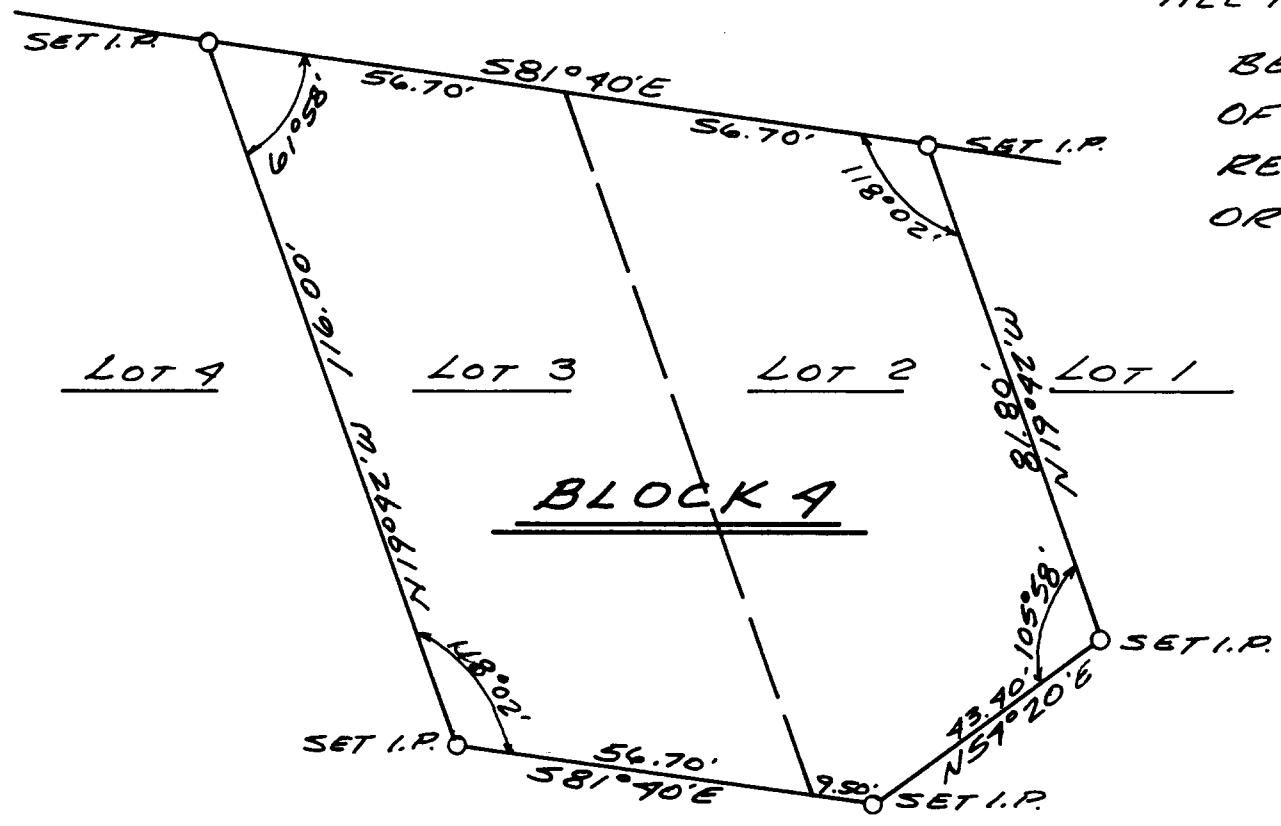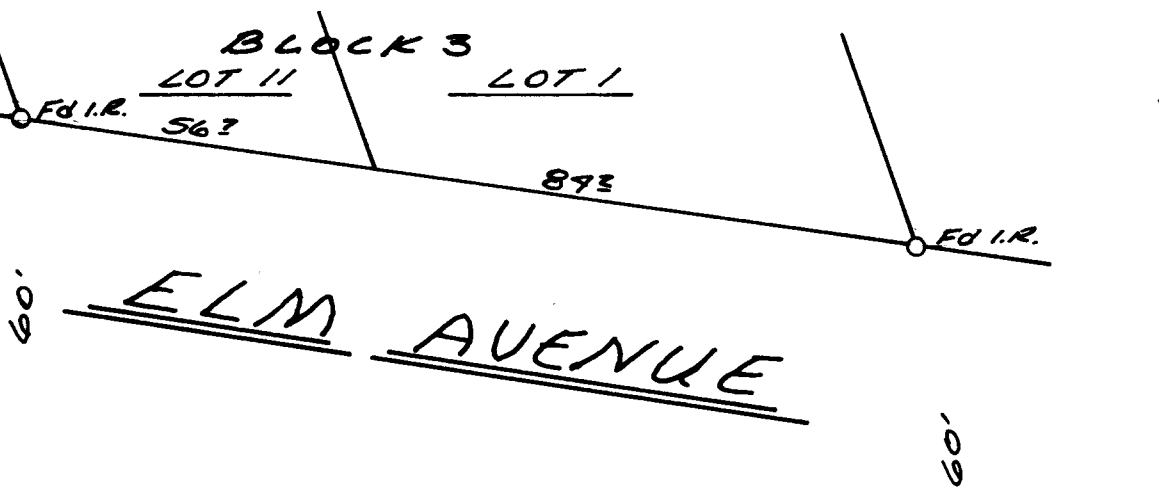

REGISTERED
 PROFESSIONAL
 LAND SURVEYOR

Robert W. Wade

OREGON
 OCTOBER 4, 1957
 ROBERT W. WADE
 433

COUNTY SURVEYORS FILE DATA
 DO NOT REMOVE FROM OFFICE

FILED
 RECEIVED

AUG 8 1972

COUNTY SURVEYOR
 5TH AND HIGHWAY COUNTY, ORE.



ENGINEERS • PLANNERS

5TH AND HIGHWAY
 COOS BAY, OREGON
 262-1166

T. 21 S. R. 12 W NW SE 1/4 SEC. 35

P. C. S. File No. 55/261-2