


○ FOUND MONUMENTS AS SHOWN

● SET 5/8" I. ROD

NOTE - BASIS OF BEARING ON CALCULATED TIE WAS USED TO OBTAIN THE BEST FIT TO THE MONUMENTS FOUND

SEE M 16-24 FOR ORIGINAL DISTANCES & BEARING

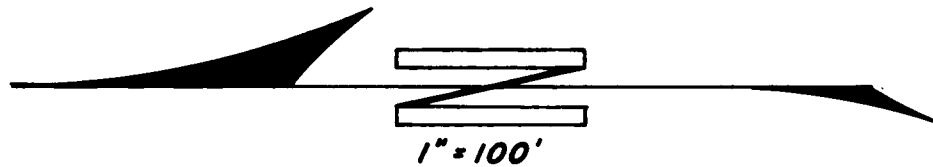

COR. SEC. 29,30,31 & 32
 T 30S, R 5W, W.M.
 N 87° 20' E 29.34 CHAINS

**COUNTY SURVEYORS FILE DATA
 DO NOT REMOVE FROM OFFICE**

SURVEY TO LOCATE BOUNDARY
 AS PER BOOK 390, PAGE 832 AND
 M 16-24

FOR D. HITCHMAN

LOCATED IN SEC 30, T 30S, R 5W, W.M.


MAY, 1973

BY HAROLD BALL - CIVIL ENGINEER - ROSEBURG, ORE.

FILED
 RECEIVED

JUN 4 1973

COUNTY SURVEYOR
 DOUGLAS COUNTY, ORE.

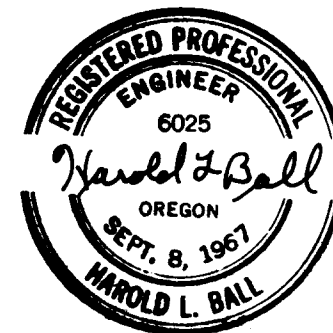

C.S. FILE No. 55/212-2