

SURVEY IN LOT 23 EDENBOWER ORCHARD TRACTS,  
SECTION 1, T.27S., R.6W., W.M.

Surveyed for OREGON WATER CORPORATION  
Surveyed by Don E. Garrett

FEB. 1973

SCALE 1" = 30'


• - DENOTES 5/8" IRON ROD SET



Fd. 2" Iron Pipe  
Initial Point Green Acres Sub.  
Vol. 7 Pg. 68

**COUNTY SURVEYORS FILE DATA  
DO NOT REMOVE FROM OFFICE**

EDENBOWER Vol. 4  
ORCHARD Pg. 56 TRACTS

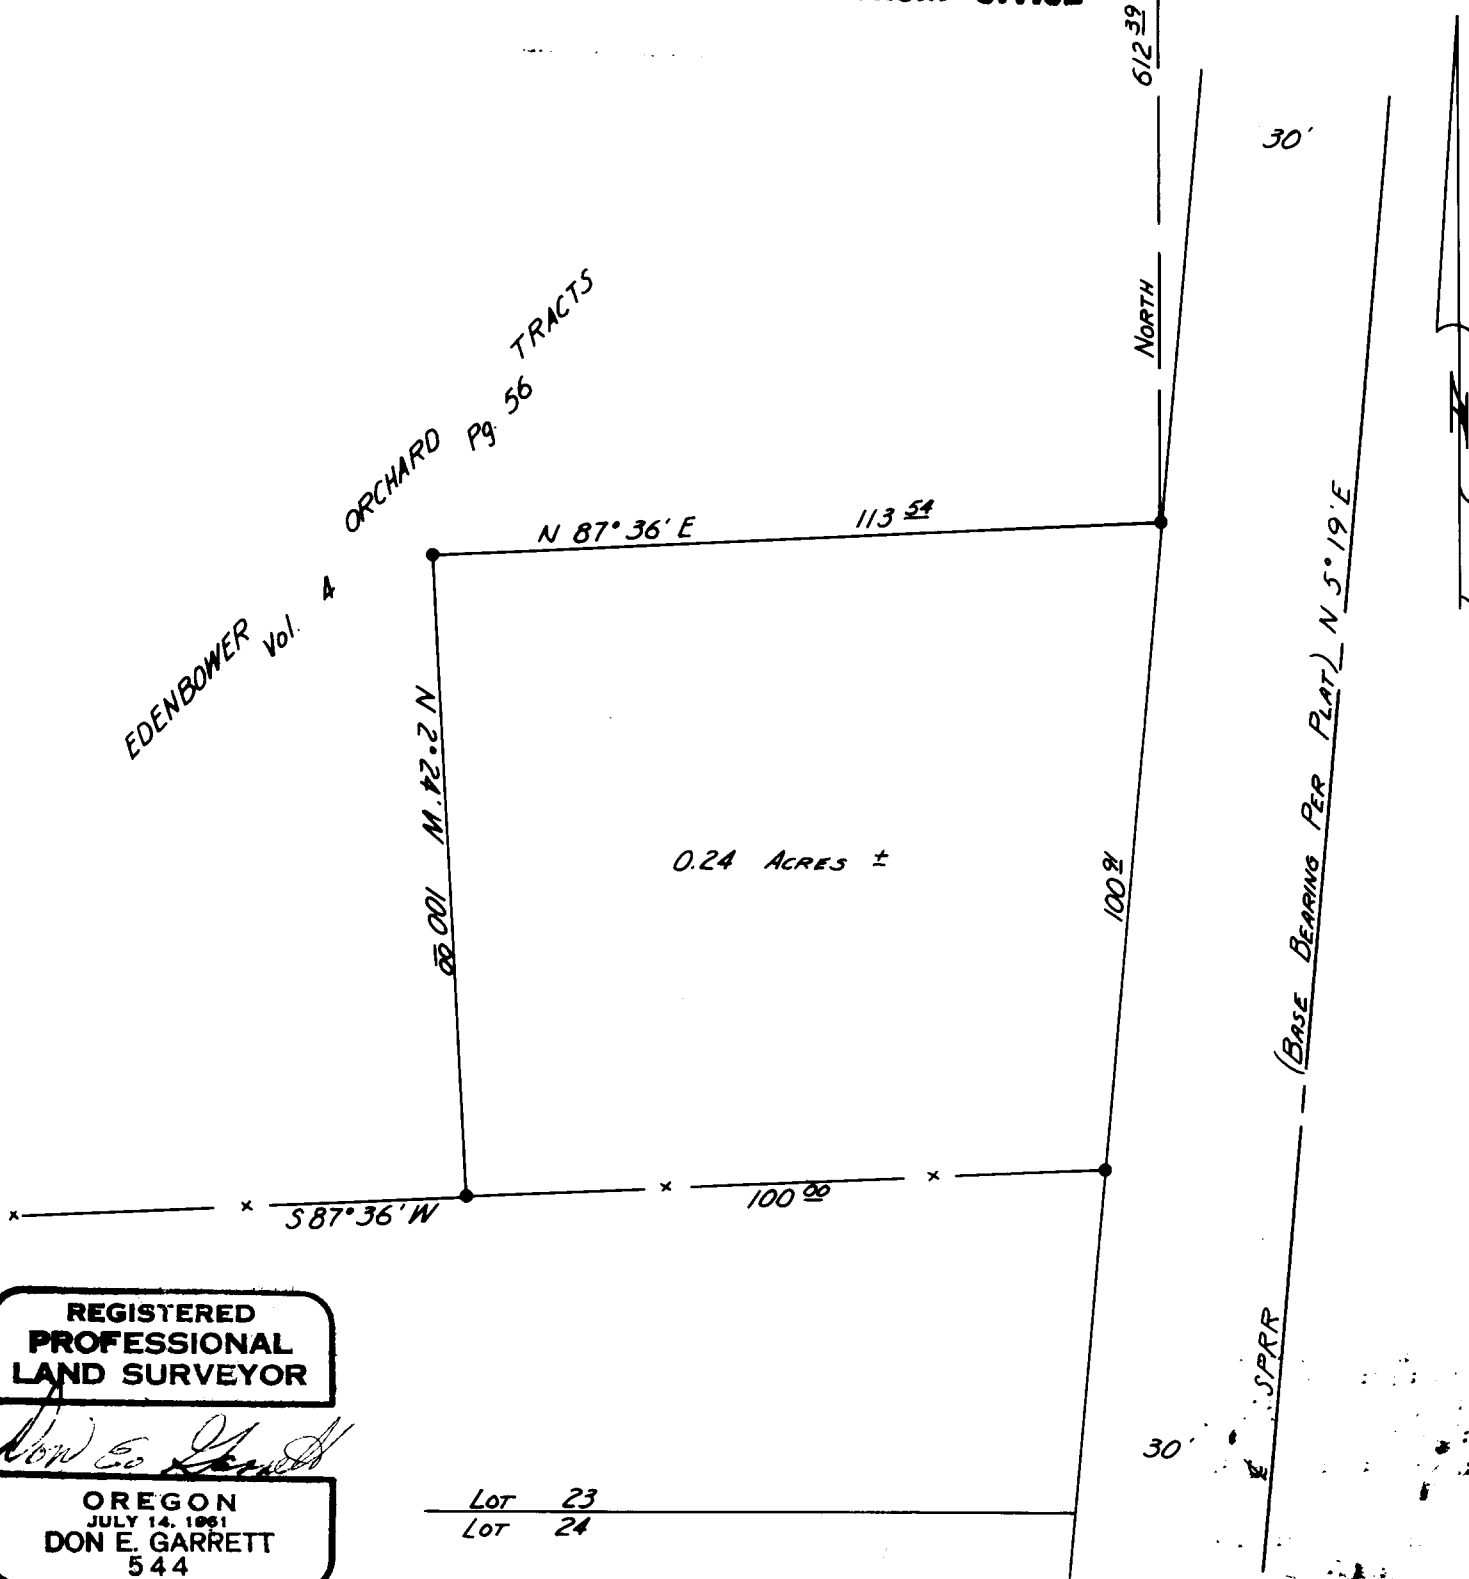

REGISTERED  
PROFESSIONAL  
LAND SURVEYOR

*Don E. Garrett*

OREGON  
JULY 14, 1961  
DON E. GARRETT  
544

Lot 23  
Lot 24