


8/27/87  
**SURVEYED FOR DEED DESCRIPTION**  
**SITUATED IN LOT 15 GLENGARRY FRUIT LANDS**  
**IN SEC 19, T. 28 S., R. 5, W. W. M.**  
**SURVEYED BY BAUGHMAN SURVEYING SERVICE**  
**SURVEY FOR MR. STANLEY McCLAIN**  
 SCALE 1" = 20' FEB. 1972

FILED  
 RECEIVED  
 JUN 12 1973  
 COUNTY SURVEYOR  
 DOUGLAS COUNTY, ORE.  
 ea

LOT 15  
 BLOCK 2

COUNTY SURVEYOR'S FIELD DATA  
 DO NOT REMOVE FROM OFFICE

0.22 AC. ±

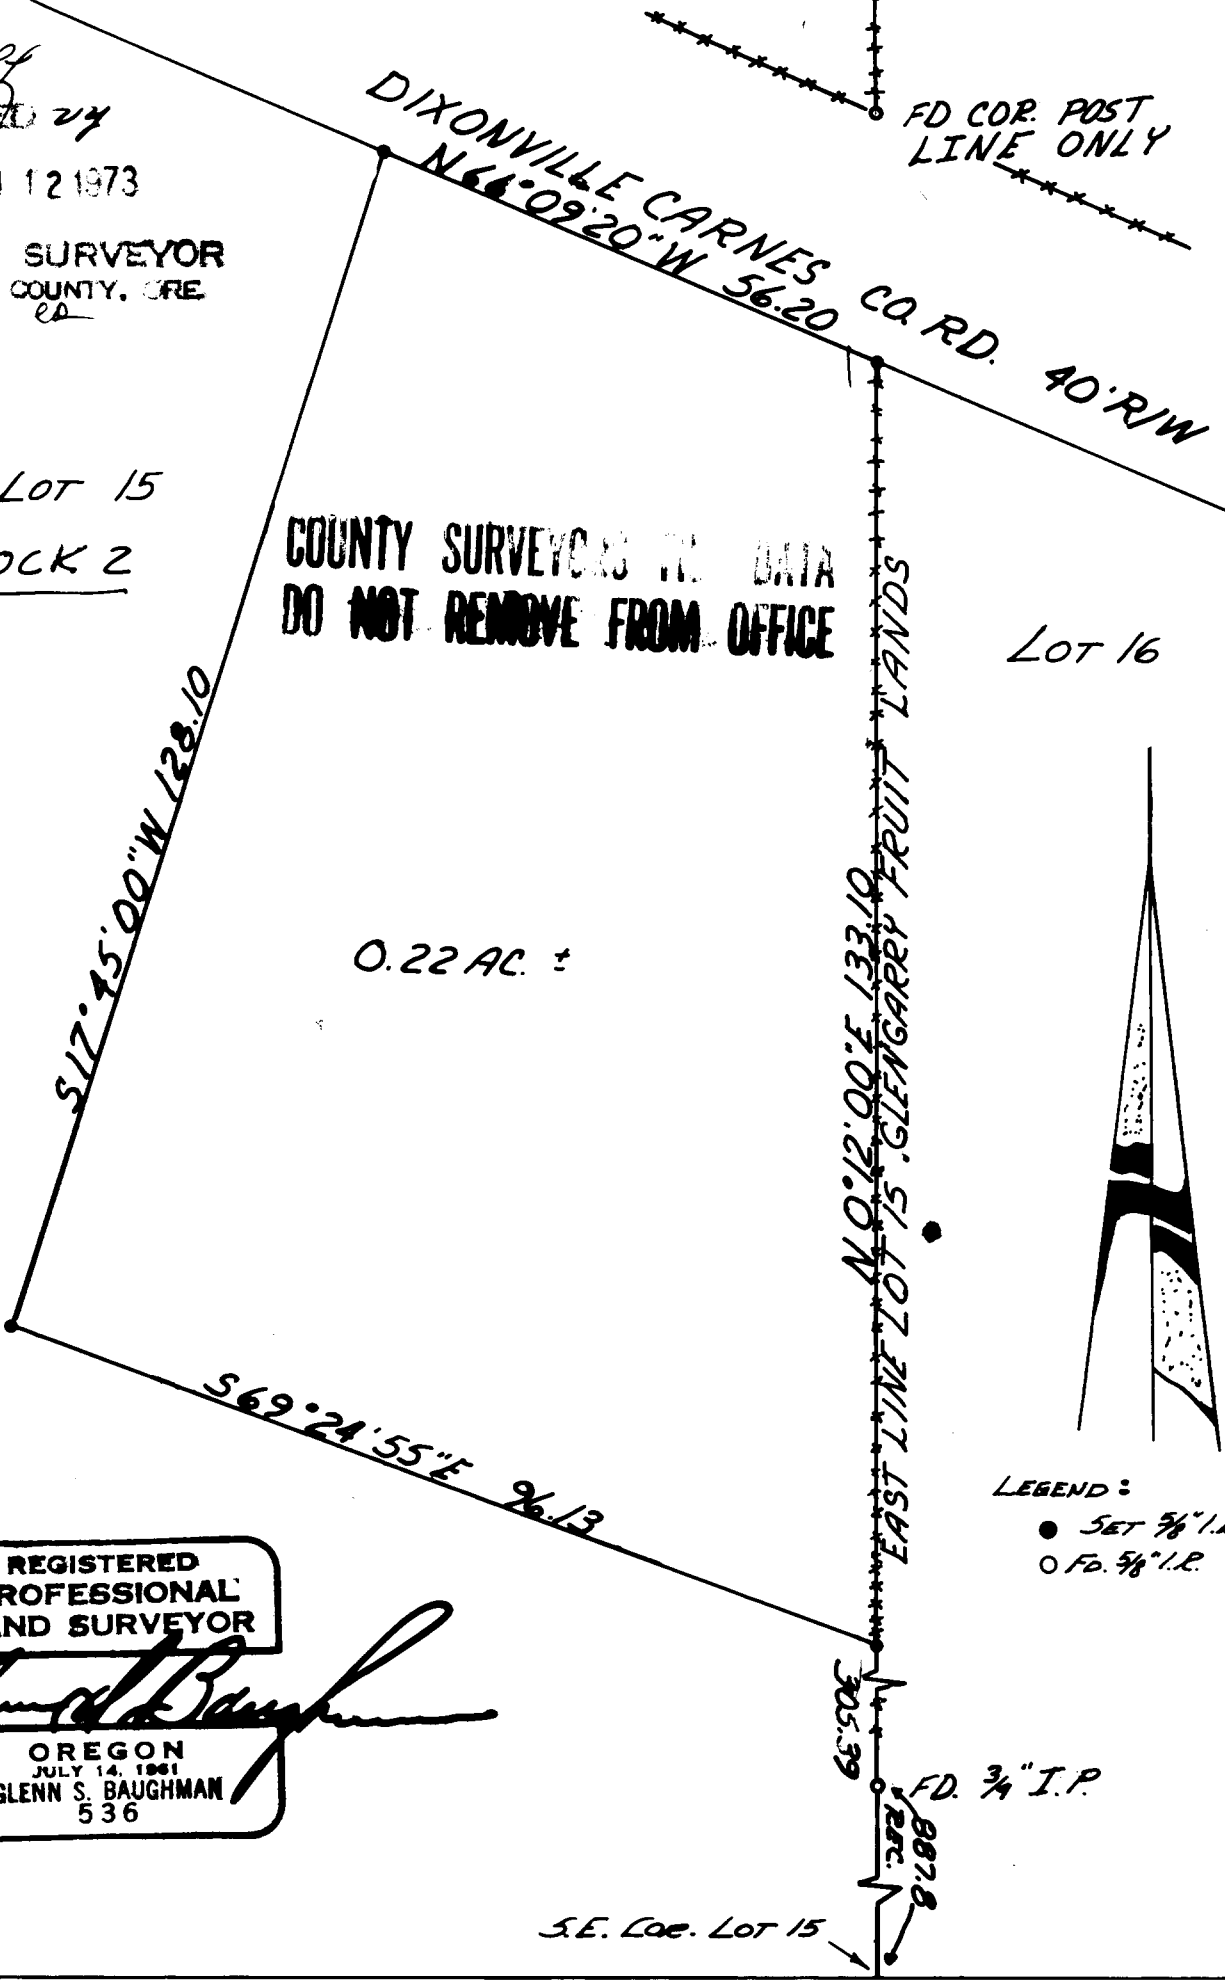

FD COR. POST  
 LINE ONLY

DIXONVILLE CARNES CO. RD. 40' R/W  
 N64°09'20\"W 56.20

LOT 16

EAST LINE LOT 15 GLENGARRY FRUIT LANDS  
 N0°12'00\"E 133.10

BASED ON EAST LINE LOT 15  
 GLENGARRY FRUIT LANDS

LEGEND:  
 ● SET 3/4\" I.P.  
 ○ FD. 3/4\" I.P.

REGISTERED  
 PROFESSIONAL  
 LAND SURVEYOR

*Glenn S. Baughman*

OREGON  
 JULY 14, 1981  
 GLENN S. BAUGHMAN  
 536

S.E. Cor. Lot 15

305.39  
 66  
 887.8  
 887.8  
 FD. 3/4\" I.P.