

SURVEY TO SET PROPERTY CORNER
 IN LOT 6, BLOCK 3, FAIRACRES
 SECTION 36, T.26S., R.6W.W.M.

FOR: SANDERS

BY: BAUGHMAN SURVEYING SERVICE


OCTOBER 1973 SCALE: 1"=50'

FILED 29
 RECEIVED 29

NOV 8 1973

COUNTY SURVEYOR
 DOUGLAS COUNTY, ORE.
mz

COUNTY SURVEYORS FILE DATA
 DO NOT REMOVE FROM OFFICE

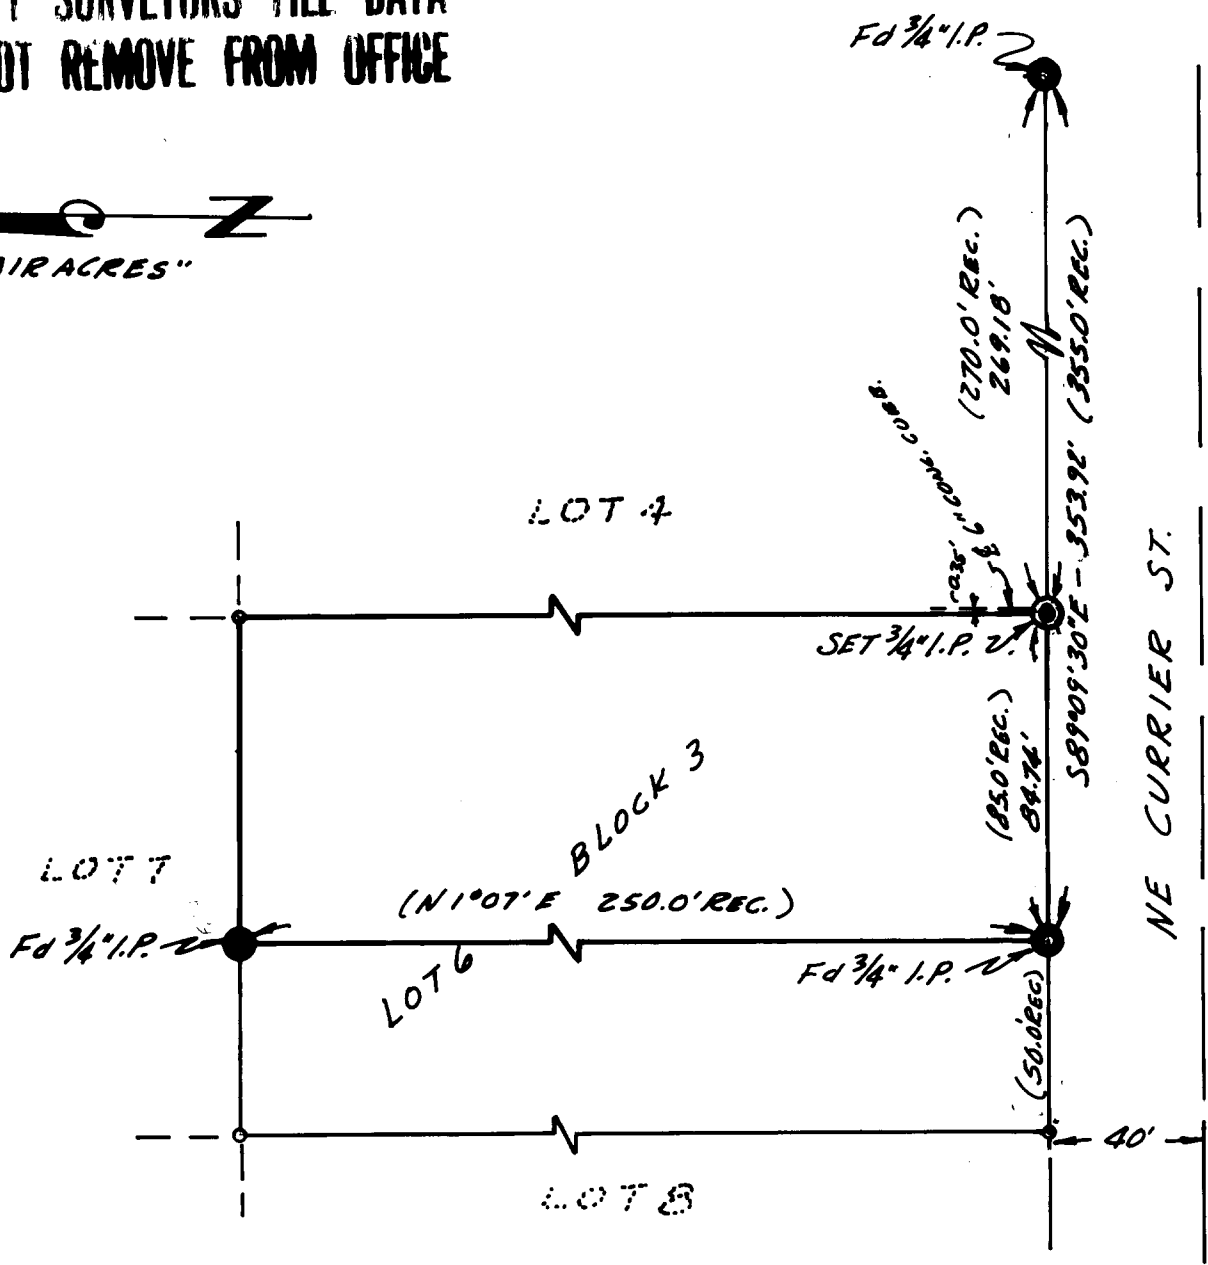

REGISTERED
 PROFESSIONAL
 LAND SURVEYOR

Eugene A. Bloom

OREGON
 MAY 12, 1960
 EUGENE A. BLOOM
 492