


COUNTY SURVEYORS FILE DATA  
DO NOT REMOVE FROM OFFICE


FILED ✓  
RECEIVED *dy*  
DEC 3 1973

COUNTY SURVEYOR  
DOUGLAS COUNTY, OREGON  
*mx*

HAWTHORN AVE.  
S 42° 23' W

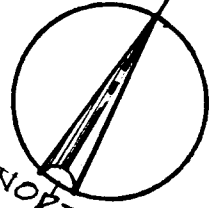

MON. FOUND ●  
MON. SET ○

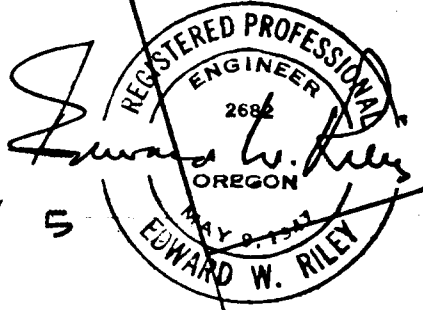

4TH STREET  
S 19° 42' E

FOUND 3/4" φ I.R.

78.0  
96.44  
93.75

49.75

BLOCK 48

10

9

8

7

6

5

93.44

52.1

52.1

104.2

62.0

SET 5/8" φ I.R.

100

8

(REC. S 47° 37' E)  
108

SET 5/8" φ I.R.

S 58° 50' W

RAINBOW PLAZA  
(RAINBOW BASIN)

FOUND 3/4" φ IRON PIPE

SEC. 35, TWP 21 S, RGE 12 W

PROPERTY SURVEY FOR  
LOT 6 & 7, BLOCK 48 CENTRAL LINCOLN PEOPLE  
AMENDED PLAT OF RAILROAD UTILITY DISTRICT  
ADDITION TO REEDSPORT  
DOUGLAS COUNTY, OREGON.  
SCALE 1" = 50' SURVEY 10-20-73.  
11-29-73.

664-A-73

S. File No. 55/324