

FILED 7
RECEIVED mL



FEB 28 1974

COUNTY SURVEYOR
DOUGLAS COUNTY, ORE.

SURVEY TO SET PROPERTY CORNS.
LOTS 4 & 5, BL. 11, BROOKSIDE 3RD
IN SEC. 21, T. 27S., R. 5 W. W. M.
FOR MRS. IDELLA F. KINCAID
BY BRUCE ROGERS
AUG., 1973
1" = 100'



Bruce R. Rogers

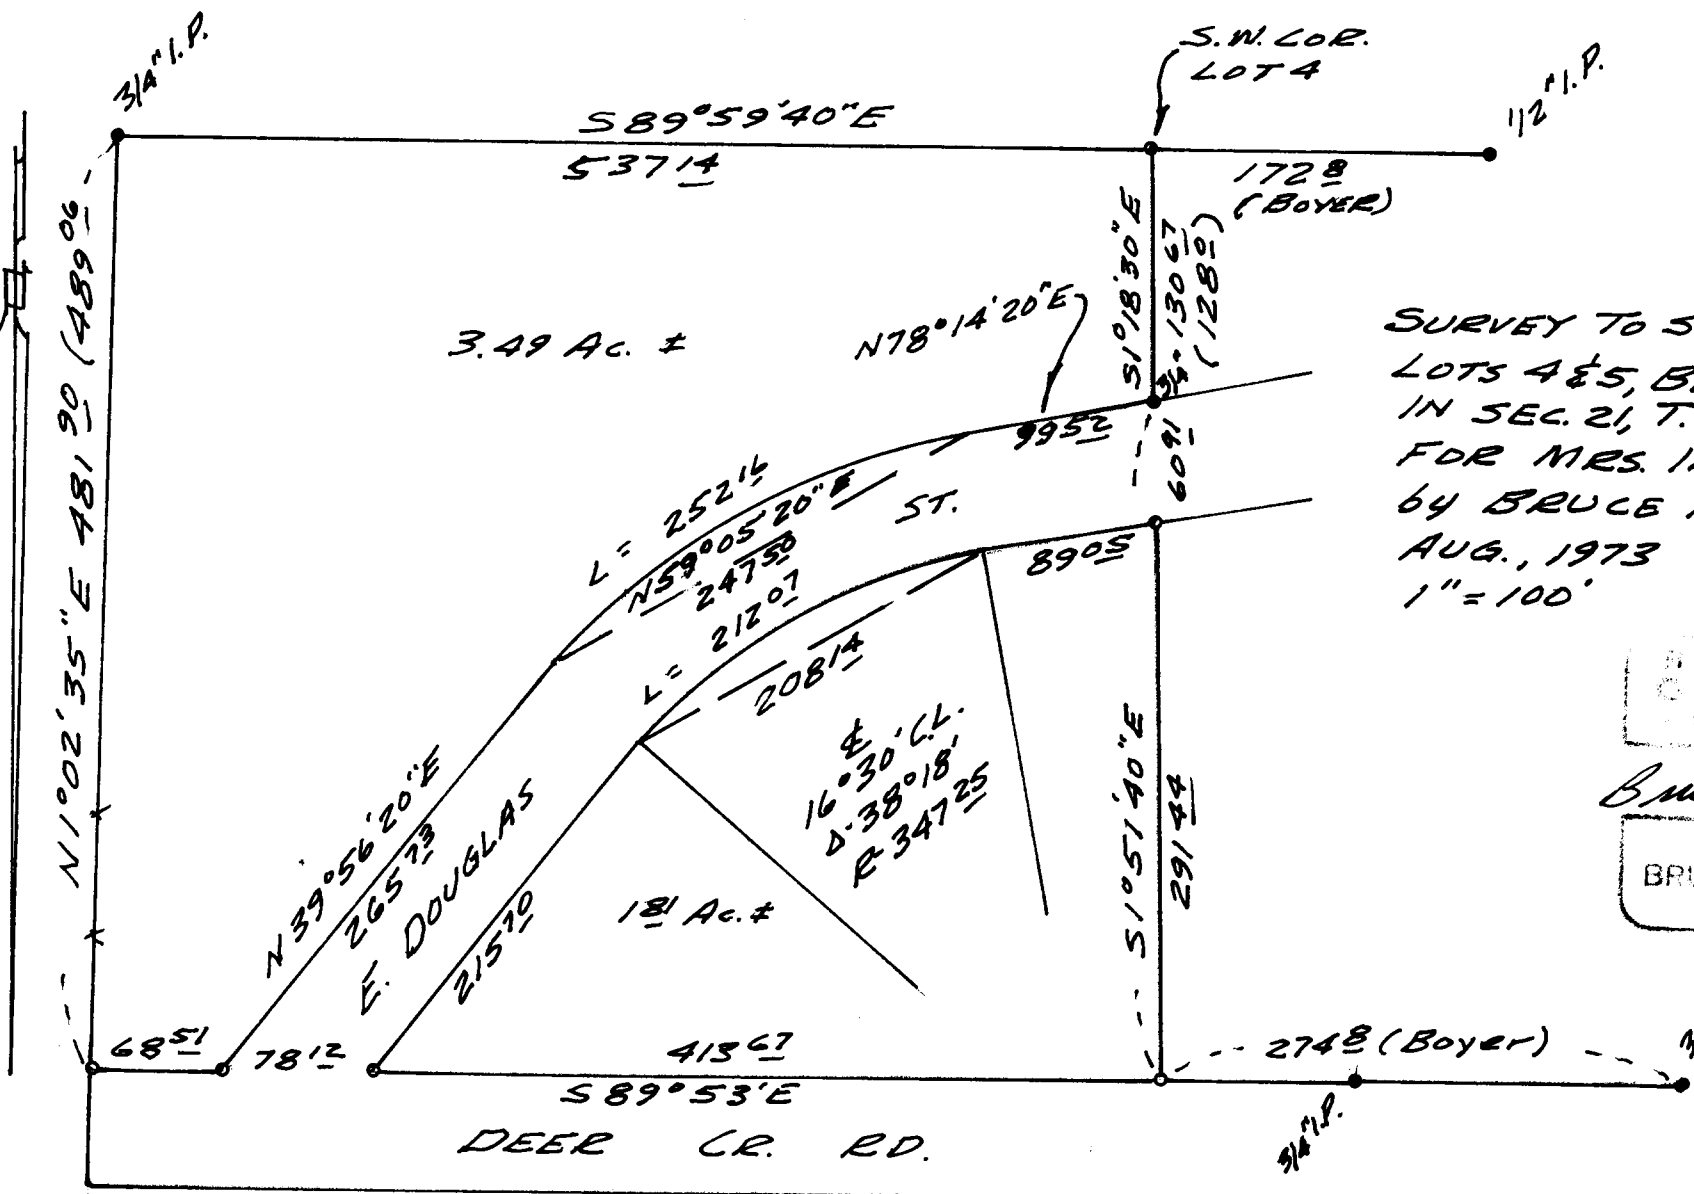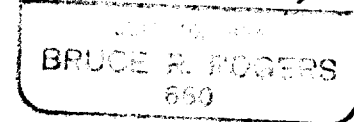

COUNTY SURVEYORS FILE DATA

• - FOUND I.P.
○ - SET 5/8" I.R.
Bearings based on Boyer's survey of Lot 3 - 51° 18' 30" E
DO NOT REMOVE FROM OFFICE