

FILED ✓
RECEIVED ✓


FEB 7 1974

COUNTY SURVEYOR
DOUGLAS COUNTY, OREGON
[Signature]

COUNTY SURVEYORS FILE DATA
DO NOT REMOVE FROM OFFICE

LOT 8 MELROSE ACRES
D.L.C. NO. 50 T27S, R6WWM
DOUGLAS COUNTY OREGON

Surveyed for Neil Flanagan
Monuments found ⊙
Monuments set ○
Bearings are from the plat.
Scale 1" = 40'
Sept. 19, 1973
By F.R. Flanagan PLS 295

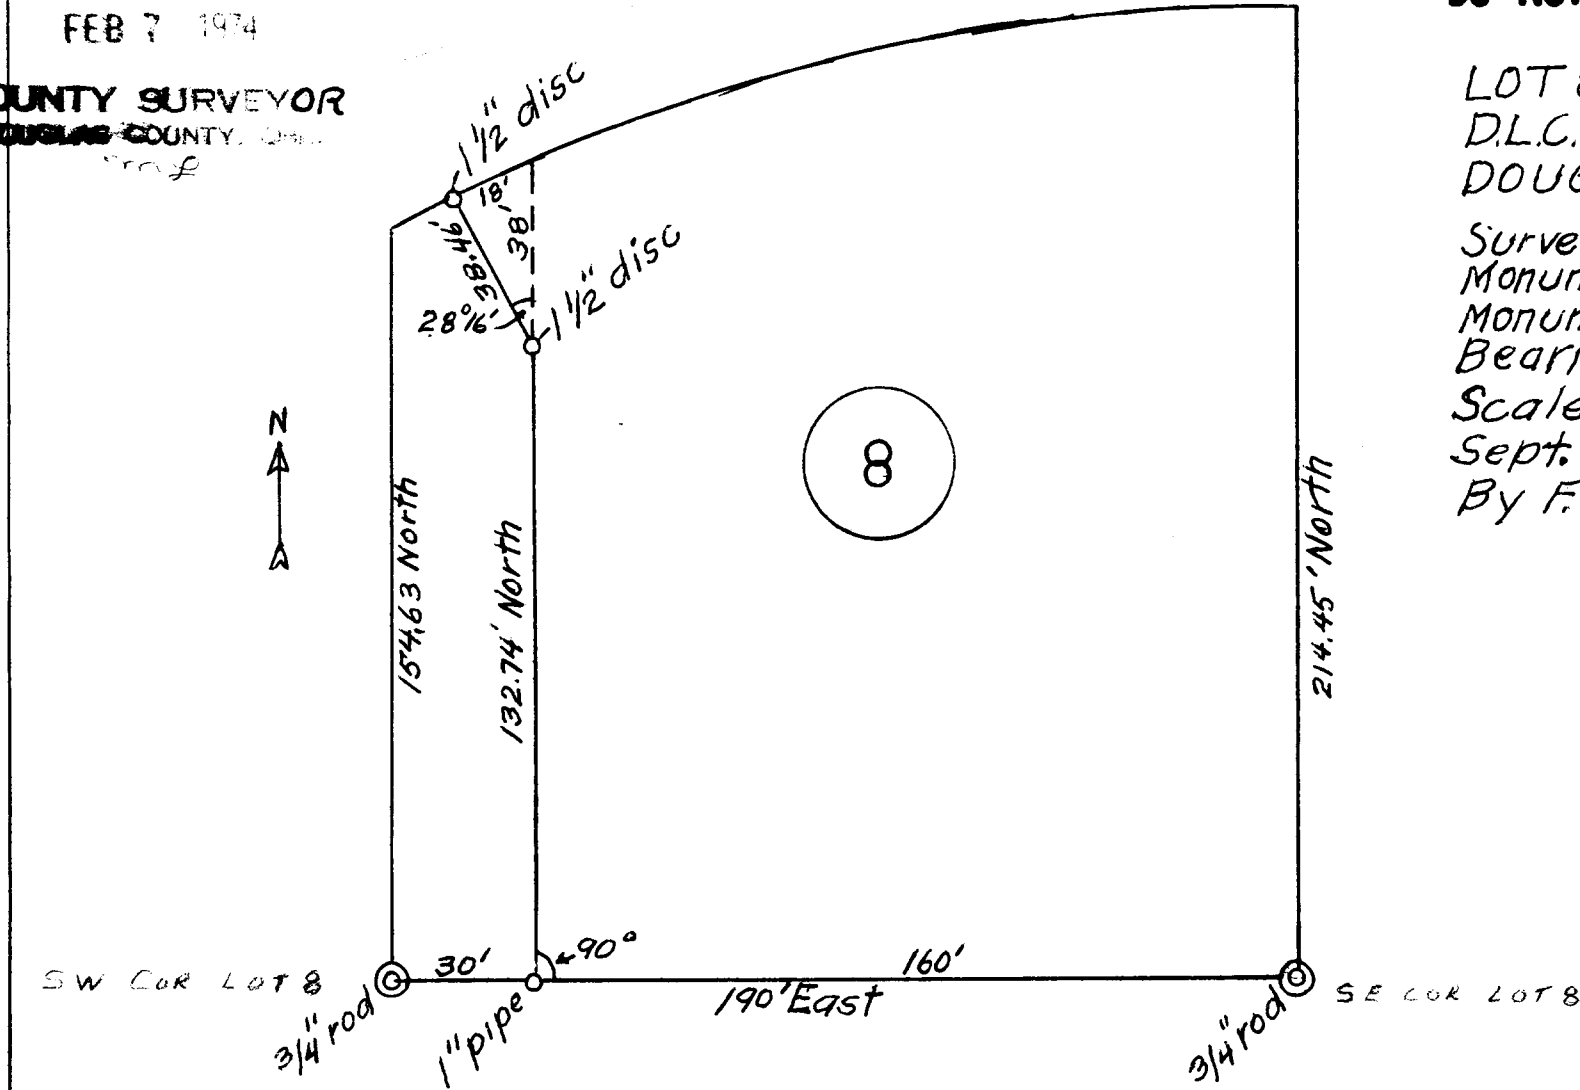

REGISTERED
PROFESSIONAL
LAND SURVEYOR
F.R. Flanagan
O.R.S. 31.010
NOV 7 1952
FRANCIS R. FLANAGAN
295