


COUNTY SURVEYOR HAS THE DATA
DO NOT REMOVE FROM OFFICE

FILED *2*
RECEIVED *24*

SEP 6 1974

COUNTY SURVEYOR
DOUGLAS COUNTY, ORE.

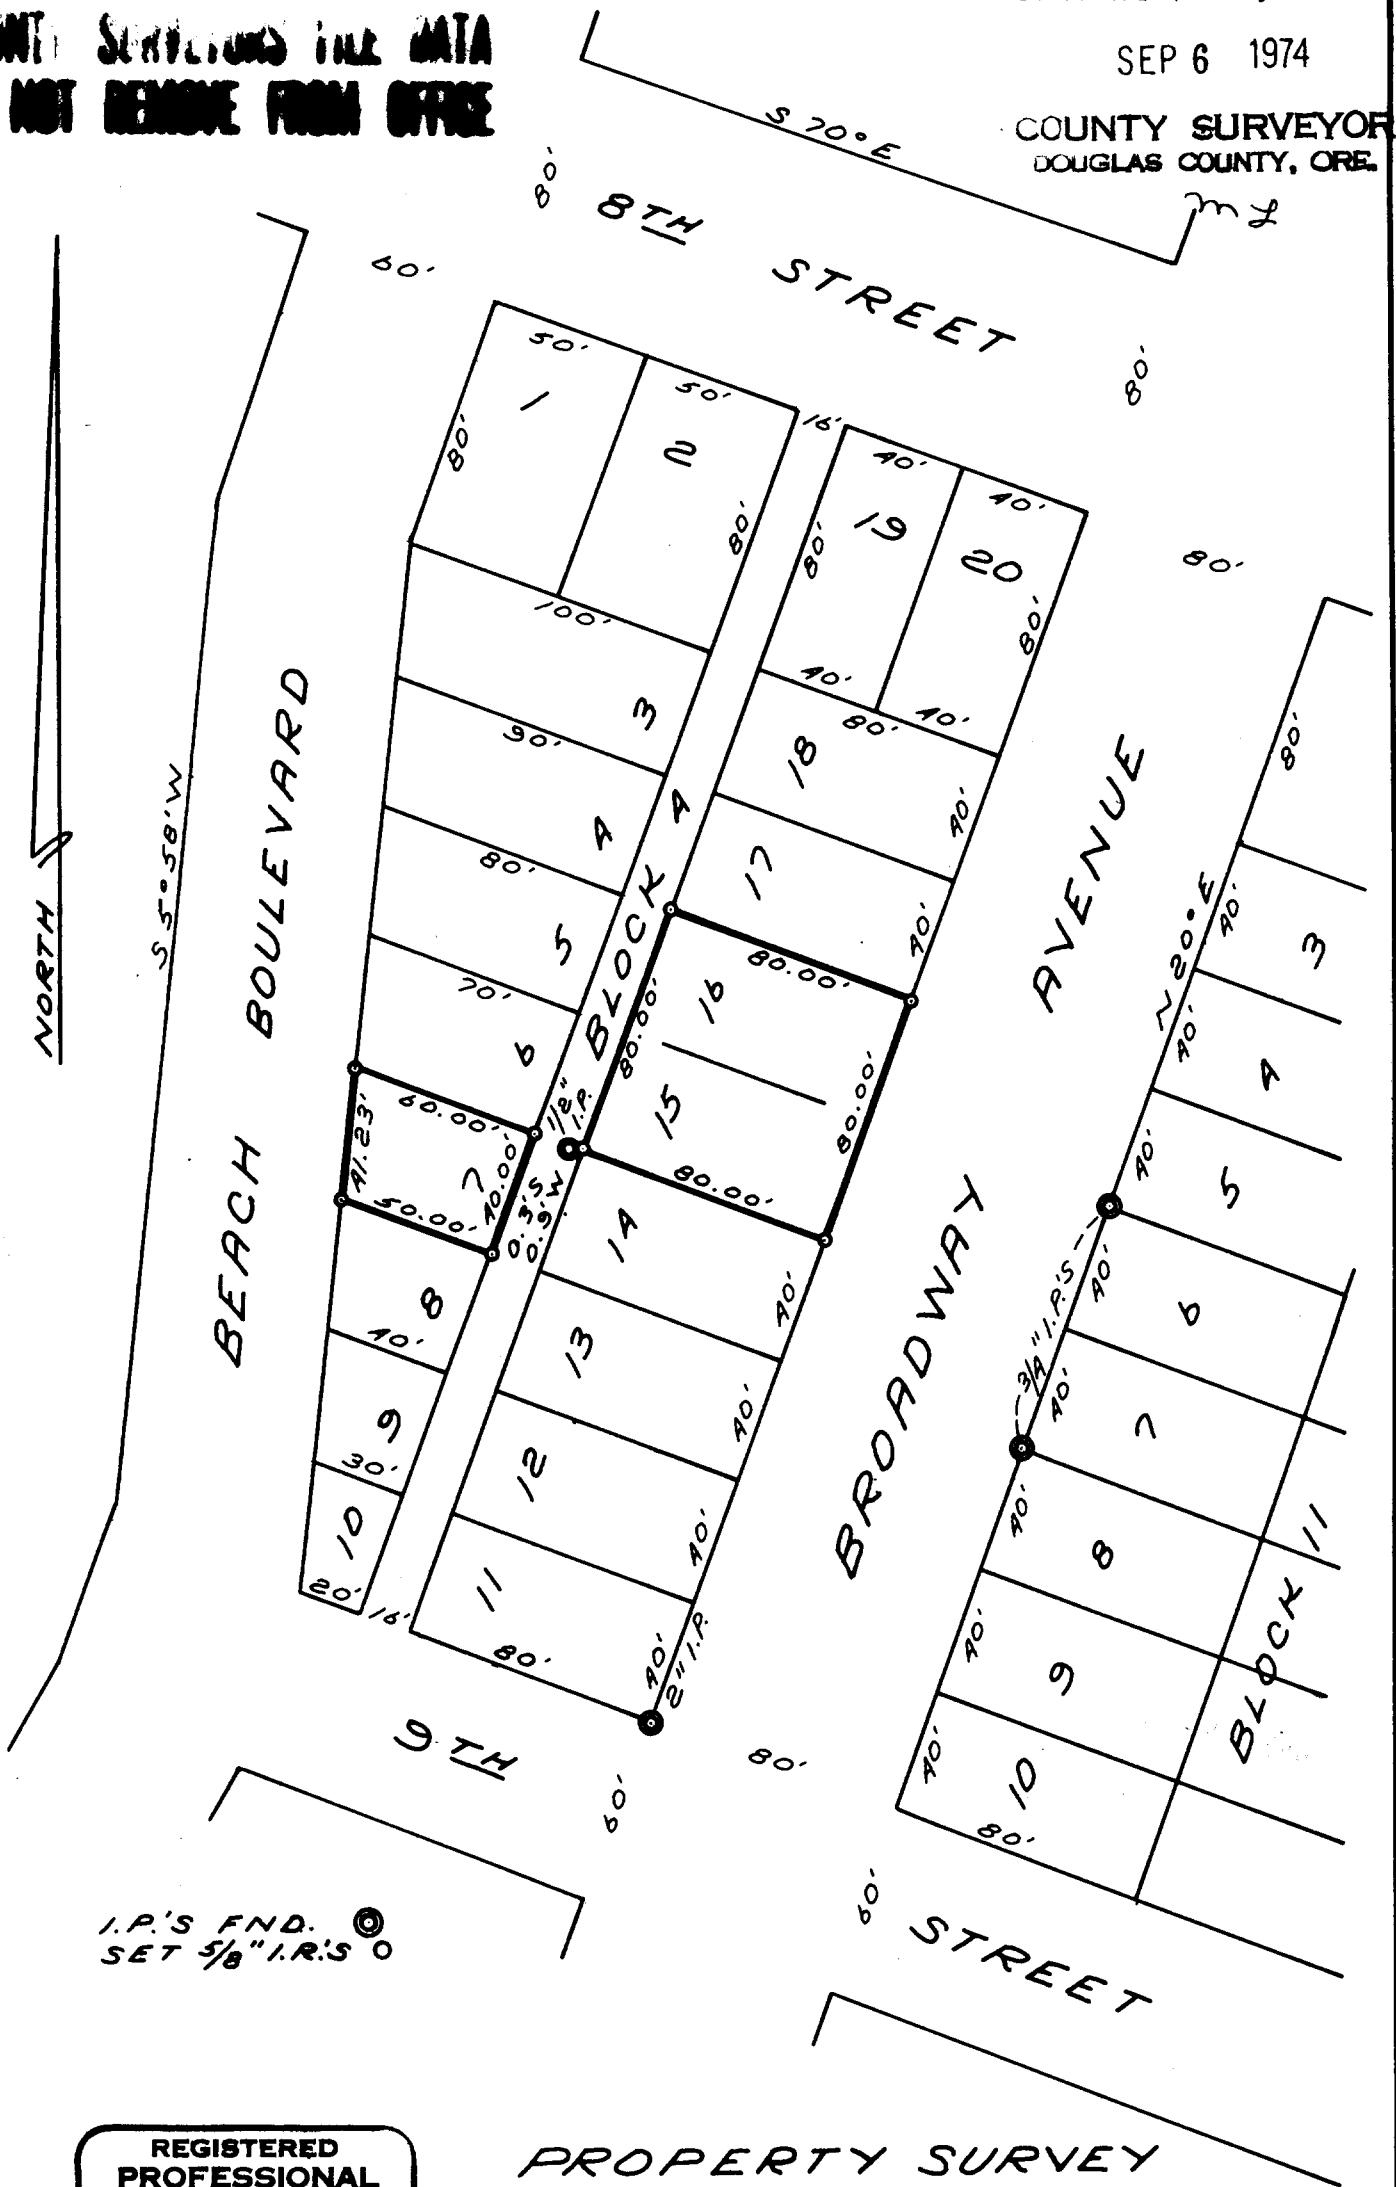

I.P.'S FND.
SET 5/8" I.R.'S

REGISTERED
PROFESSIONAL
LAND SURVEYOR

Richard J. Hintz

OREGON
MAY 19, 1960
RICHARD J. HINTZ
497

PROPERTY SURVEY
FOR
WARREN McMURRAY
LOTS 7, 15 & 16; BLK. 4
WINCHESTER BAY
SEPT. 1974 SCALE 1"=60'

T.22S. R.12W. SEC.7

C. S. File No. 55/340-2