

COUNTY SURVEYORS FILE DATA
DO NOT REMOVE FROM OFFICE

SURVEY FOR DEED DESCRIPTION IN SEC. 26, T29S, R6W. W.M.

SURVEYED FOR - OTIS CLAYTON
SURVEYED BY - W.S. BARNES


MAR. 1974
SCALE 1" = 200'

FILED ✓
RECEIVED *ml*

MAR 20 1974

COUNTY SURVEYOR
DOUGLAS COUNTY, ORE.

ml

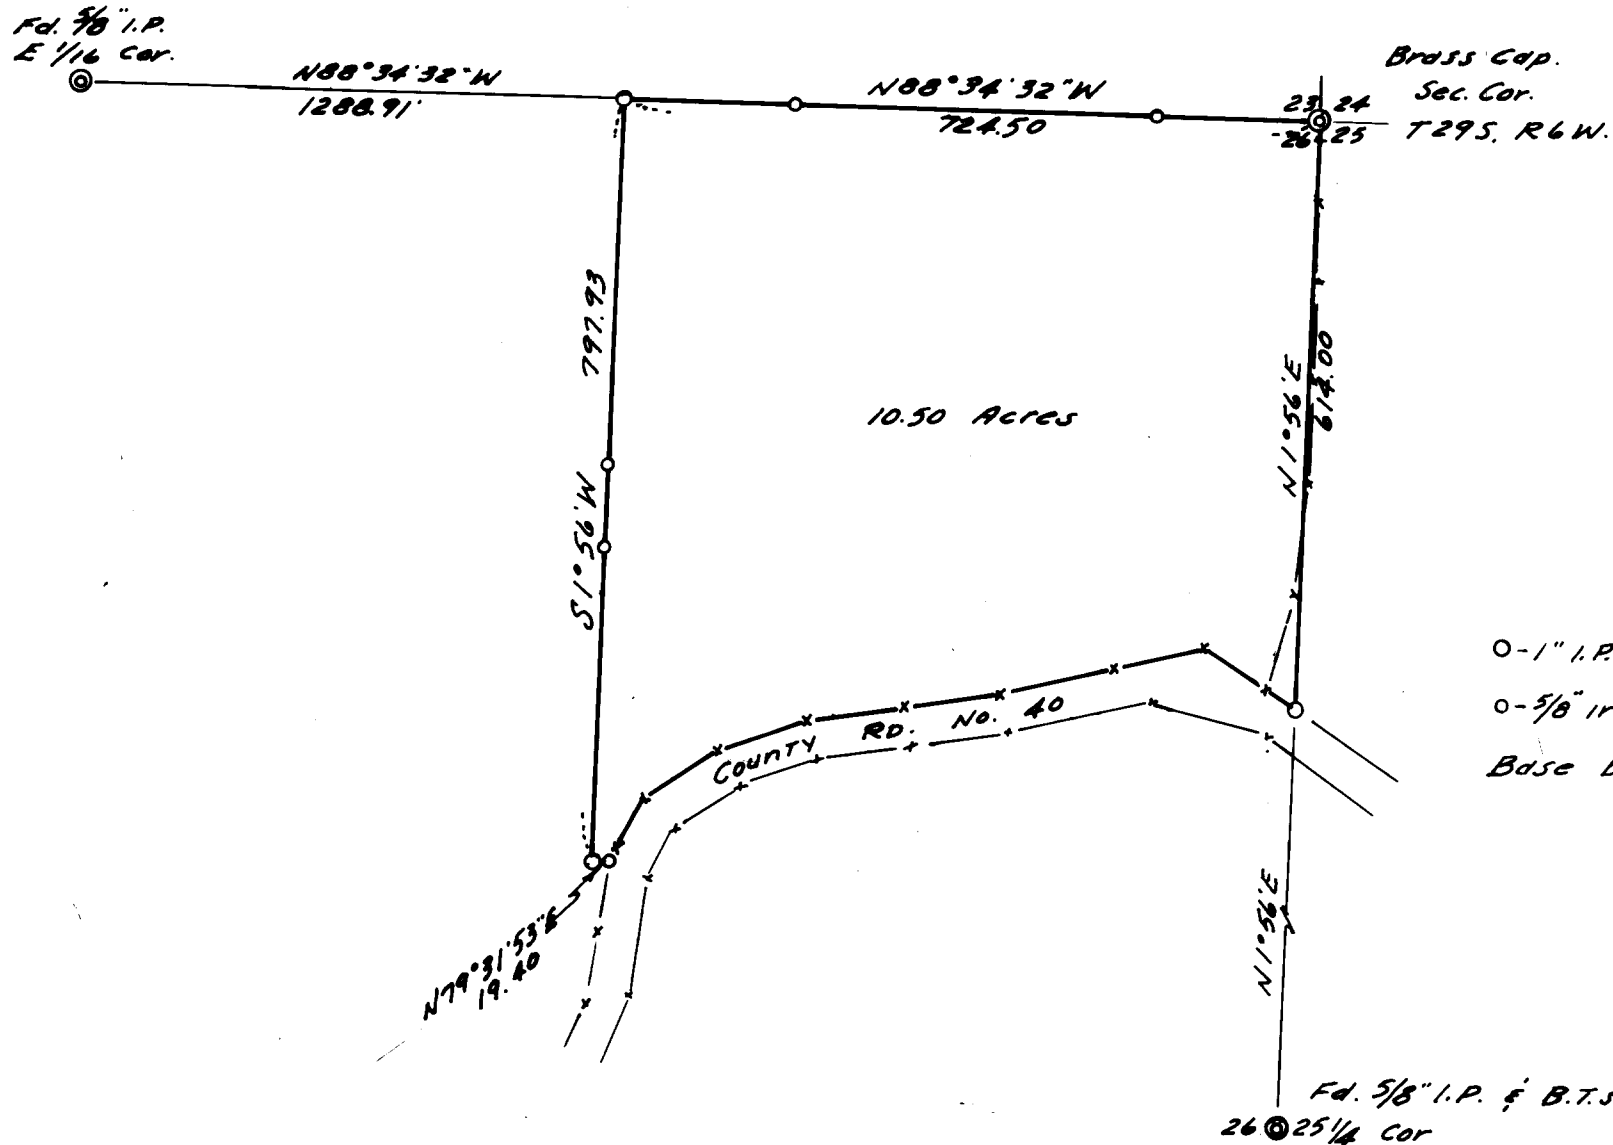

0-1" I.P.s set

0-5/8" iron rods set.

Base bearing taken from sec. line 2625

Fd. 5/8" I.P. & B.T.s
26 © 25 1/4 Cor



S. File No. 55/3A1-1