


FD. 1" I. PIPE
(SEE M 32-32)

FILED ✓
RECEIVED ✓

MAR 20 1974

COUNTY SURVEYORS FILE DATA
DO NOT REMOVE FROM OFFICE

COUNTY SURVEYOR
DOUGLAS COUNTY, ORE.
md

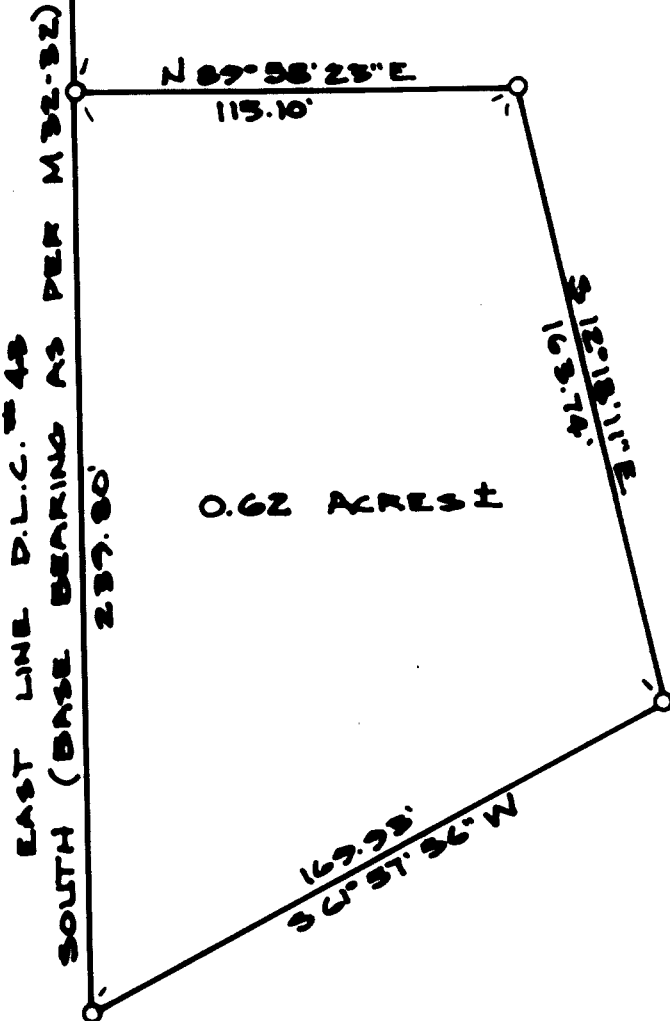

○ — DESIGNATES SET 1/2" I. PIPE


REGISTERED
PROFESSIONAL
LAND SURVEYOR

Romanso E. Ware

OREGON
NOV. 16, 1973
ROMANSO E. WARE
1005

SURVEY IN SECTION 10, T27S, R6W, W.M.

SURVEY FOR DARLEY E. WARE
SURVEY BY ROMANSO E. WARE
MARCH, 1974

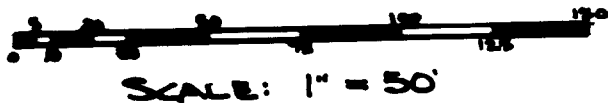

FD. 3/4" I. ROD
S.E. COR JACOB JONES D.L.C. No. 43

C.S. File No. 55/342-