


CERTIFIED RECORD OF LAND CORNER MONUMENTATION


History of original corner establishment:

NONE

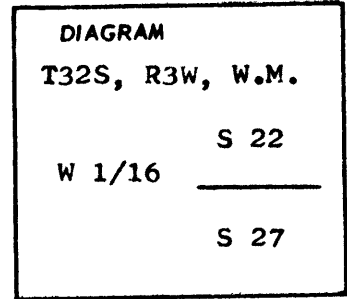

Description of corner evidence found:

NONE

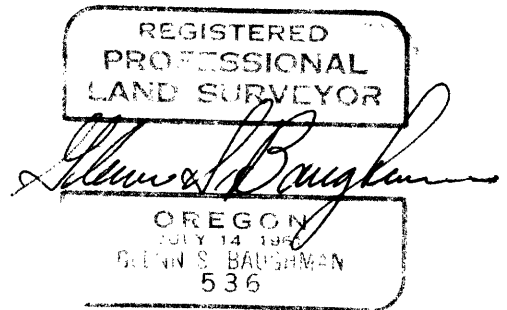

Description of monument and accessories established to perpetuate the original location of this corner

I set a 36-inch long, 2 1/2 inch diameter galvanized iron pipe 30 inches in the ground, in a mound of stones, with a 4-inch brass cap marked:

Bearing trees:

a madrona, 7 inches diameter bears
 S 24° E 31.5 feet scribed W 1/16 S 27 (BT)
 with a brass washer stamped RLS 536

a white fir, 7 inches diameter bears
 N 23° E 36.0 feet scribed W 1/16 S 22 (BT)
 with a brass washer stamped RLS 536

	S 22
W1/16	_____
	S 27
RLS 536	1974

From Book #6, page 10, Tiller Land Survey #13 - Contract #004346N.

Office of..... County of.....
 State of....., I hereby certify that the within instrument was filed in this office
 for record on the day of....., 19....., at..... o'clockm., (signed)
 by
 (COUNTY OFFICIAL) (DEPUTY)

FILED
RECEIVED *Sell*
M 44-27
 AUG 8 1974

COUNTY SURVEYOR
DOUGLAS COUNTY, ORE.