


CERTIFIED RECORD OF LAND CORNER MONUMENTATION

History of original corner establishment:

NONE

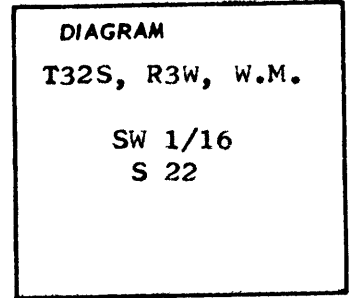

Description of corner evidence found:

NONE

REGISTERED
PROFESSIONAL
LAND SURVEYOR

Glenn S. Baughman
OREGON
JULY 1 1974
GLENN S. BAUGHMAN
536

Description of monument and accessories I established to perpetuate the original location of this corner

I set a 36-inch long, 2 1/2 inch diameter galvanized iron pipe 30 inches in the ground, in a mound of stones, with a 4-inch brass cap marked:

Bearing trees:

SW 1/16
S 22
RLS 536 1974

a douglas fir, 10 inches diameter bears N 78° W
9.0 feet scribed SW 1/16 S 22 (BT) with a
brass washer stamped RLS 536

a douglas fir, 9 inches diameter bears N 19° E
16.8 feet scribed SW 1/16 S 22 (BT) with a
brass washer stamped RLS 536

Corner lies on 40% Northwest slope.

From Book #6, page 11, Tiller Land Survey #13 - Contract #004346N.

Office of County of
State of , I hereby certify that the within instrument was filed in this office
for record on the day of , 19..... , at o'clockm., (signed)
..... by
(COUNTY OFFICIAL) (DEPUTY)

FILED
RECEIVED *Stue*
M. 49-69
AUG 8 1974

COUNTY SURVEYOR
DOUGLAS COUNTY, ORE.