


CERTIFIED RECORD OF LAND CORNER MONUMENTATION


History of original corner establishment:

NONE

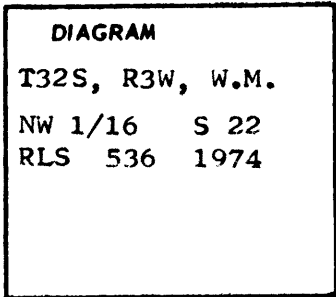

Description of corner evidence found:

NONE

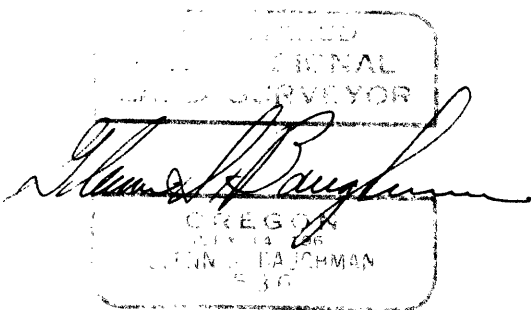

Description of monument and accessories I established to perpetuate the original location of this corner

I set a 36-inch long, 2 1/2 inch galvanized iron pipe 33 inches in the ground, in a mound of stones, with a 4-inch brass cap marked:

Bearing trees:

NW 1/16 S 22
RLS 536 1974

a douglas fir, 14 inches diameter bears S 41° E 24.5 feet scribed NW 1/16 S 22 (BT) with a brass washer stamped RLS 536

a maple, 20 inches diameter bears S 86° W 261.5 feet (one in a clump of three) scribed NW 1/16 S 22 (BT) with a brass washer stamped RLS 536

Corner lies on East edge of field.

From Book #6, page 15, Tiller Land Survey #13 - Contract #004346N

Office of..... County of.....
State of....., I hereby certify that the within instrument was filed in this office for record on the day of; 19....., at..... o'clockm., (signed)
..... by
(COUNTY OFFICIAL) (DEPUTY)

FILED
RECEIVED
M 49-69
AUG 8 1974

COUNTY SURVEYOR
DOUGLAS COUNTY, ORE.