


CERTIFIED RECORD OF LAND CORNER MONUMENTATION


History of original corner establishment:

NONE - This corner was destroyed in 1913 by Fred Mensch under General Land Office Group #14. Surveyor General Record states "I reestablished this corner in its original position for Section 15 only as follows: Set a basalt stone, 15 X 10 X 6 inches, 10 inches in the ground, for 1/4 section corner, for section 15 only, marked 1/4 on North face: from which a Fir, 24 inches diameter, bears N 37° E 25 lks. distance, marked 1/4 S 15 B T. a Fir, 20 inches diameter, bears N 30° W, 37 lks. distance, marked 1/4 S 15 B T. I destroy the marks on the bearing tree south of line.

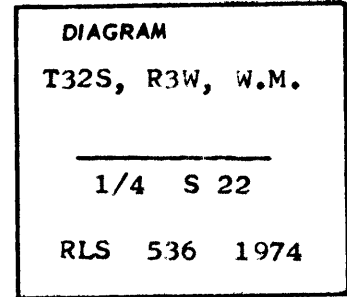

Description of corner evidence found:

NONE

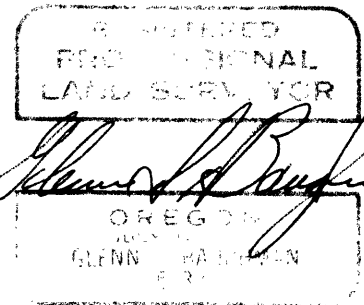

Description of monument and accessories I established to perpetuate the original location of this corner

I set a 36-inch long, 2 1/2 inch galvanized iron pipe 32 inches in the ground, in a mound of stones, with a 4-inch brass cap marked:

Bearing trees:

a cedar, 15 inches diameter bears S 77° W 10.3 feet scribed 1/4 S 22 (BT) with a brass washer stamped RLS 536

a douglas fir, 26 inches diameter bears S 35° E 63.6 feet scribed 1/4 S 22 (BT) with a brass washer stamped RLS 536

1/4 S 22
T32S R3W
RLS 536 1974

Corner lies on gradual Southwest slope, approximately 200 feet Northeast of creek.

From Book #6, page 19, Tiller Land Survey #13 - Contract #004346N.

Office of..... County of.....
State of....., I hereby certify that the within instrument was filed in this office for record on the day of; 19....., at..... o'clockm., (signed)
..... by
(COUNTY OFFICIAL) (DEPUTY)

FILED
RECEIVED *Sue*
M 49-69
AUG 8 1974

COUNTY SURVEYOR
DOUGLAS COUNTY, ORE.