


CERTIFIED RECORD OF LAND CORNER MONUMENTATION

History of original corner establishment:

NONE

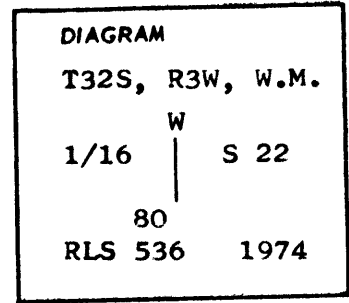

Description of corner evidence found:

NONE

REGISTERED PROFESSIONAL LAND SURVEYOR
---

*Glenn S. Baughman*

OREGON JULY 14, 1951 GLENN S. BAUGHMAN 536
---


Description of monument and accessories I established to perpetuate the original location of this corner

I set a 36-inch long, 2 1/2 inch galvanized iron pipe 32 inches in the ground, in a mound of stones, with a 4-inch brass cap marked:

Bearing trees:

a white fir, 8 inches diameter bears N 66° W 20.3 feet scribed W 1/16 80 S 22 (BT) with a brass washer stamped RLS 536

a grand fir, 20 inches diameter bears N 8° E 66.2 feet scribed W 1/16 80 S 22 (BT) with a brass washer stamped (RLS 536)

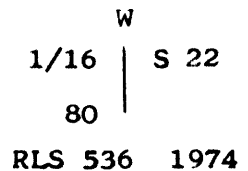

Corner lies approximately 40 feet West of Apple Creek high bank and along the East timber line.

From Book #6, page 16, Tiller Land Survey #13 - Contract #004346N.

Office of..... County of.....  
 State of....., I hereby certify that the within instrument was filed in this office  
 for record on the ..... day of.....; 19....., at..... o'clock .....m., (signed)  
 ..... by .....  
 (COUNTY OFFICIAL) (DEPUTY)

**FILED**  
**RECEIVED** *See*  
*M 49-69*  
**AUG 8 1974**