


CERTIFIED RECORD OF LAND CORNER MONUMENTATION

History of original corner establishment:

NONE

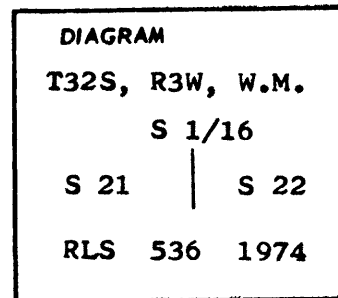

Description of corner evidence found:

NONE

Found 1" iron rod (very old) 4.27 feet East of Section Line, and 0.54 feet North of new corner.

REGISTERED
PROFESSIONAL
LAND SURVEYOR

OREGON
JULY 14, 1951
GLENN S. BAUGHMAN
536


Description of monument and accessories established to perpetuate the original location of this corner

I set a 36-inch long, 2 1/2 inch galvanized iron pipe 32 inches in the ground, in a mound of stones, with a 4-inch brass cap marked:

Bearing trees:

8 inches diameter
a hemlock/bears N 6° W 26.9 feet scribed
S 1/16 S 21 (BT) with a brass washer stamped
RLS 536

an alder, 12 inches diameter bears N 68° E
25.4 feet scribed S 1/16 S 22 (BT) with a
brass washer stamped RLS 536

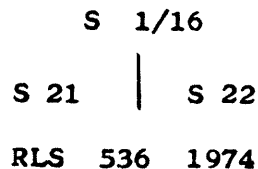

Corner lies in flat approximately 50 feet West of Applegate Creek.

From Book #6, page 22, Tiller Land Survey #13 - Contract #004346N.

Office of..... County of.....
State of....., I hereby certify that the within instrument was filed in this office
for record on the day of; 19....., at..... o'clockm., (signed)
..... by
(COUNTY OFFICIAL) (DEPUTY)

FILED
RECEIVED *Sue*
M 49-69
AUG 8 1974

COUNTY SURVEYOR
DOUGLAS COUNTY, ORE.