


FILED  
RECEIVED

JUN 11 1971

COUNTY SURVEYOR  
DOUGLAS COUNTY, ORE.

COUNTY SURVEYORS FILE DATA  
DO NOT REMOVE FROM OFFICE

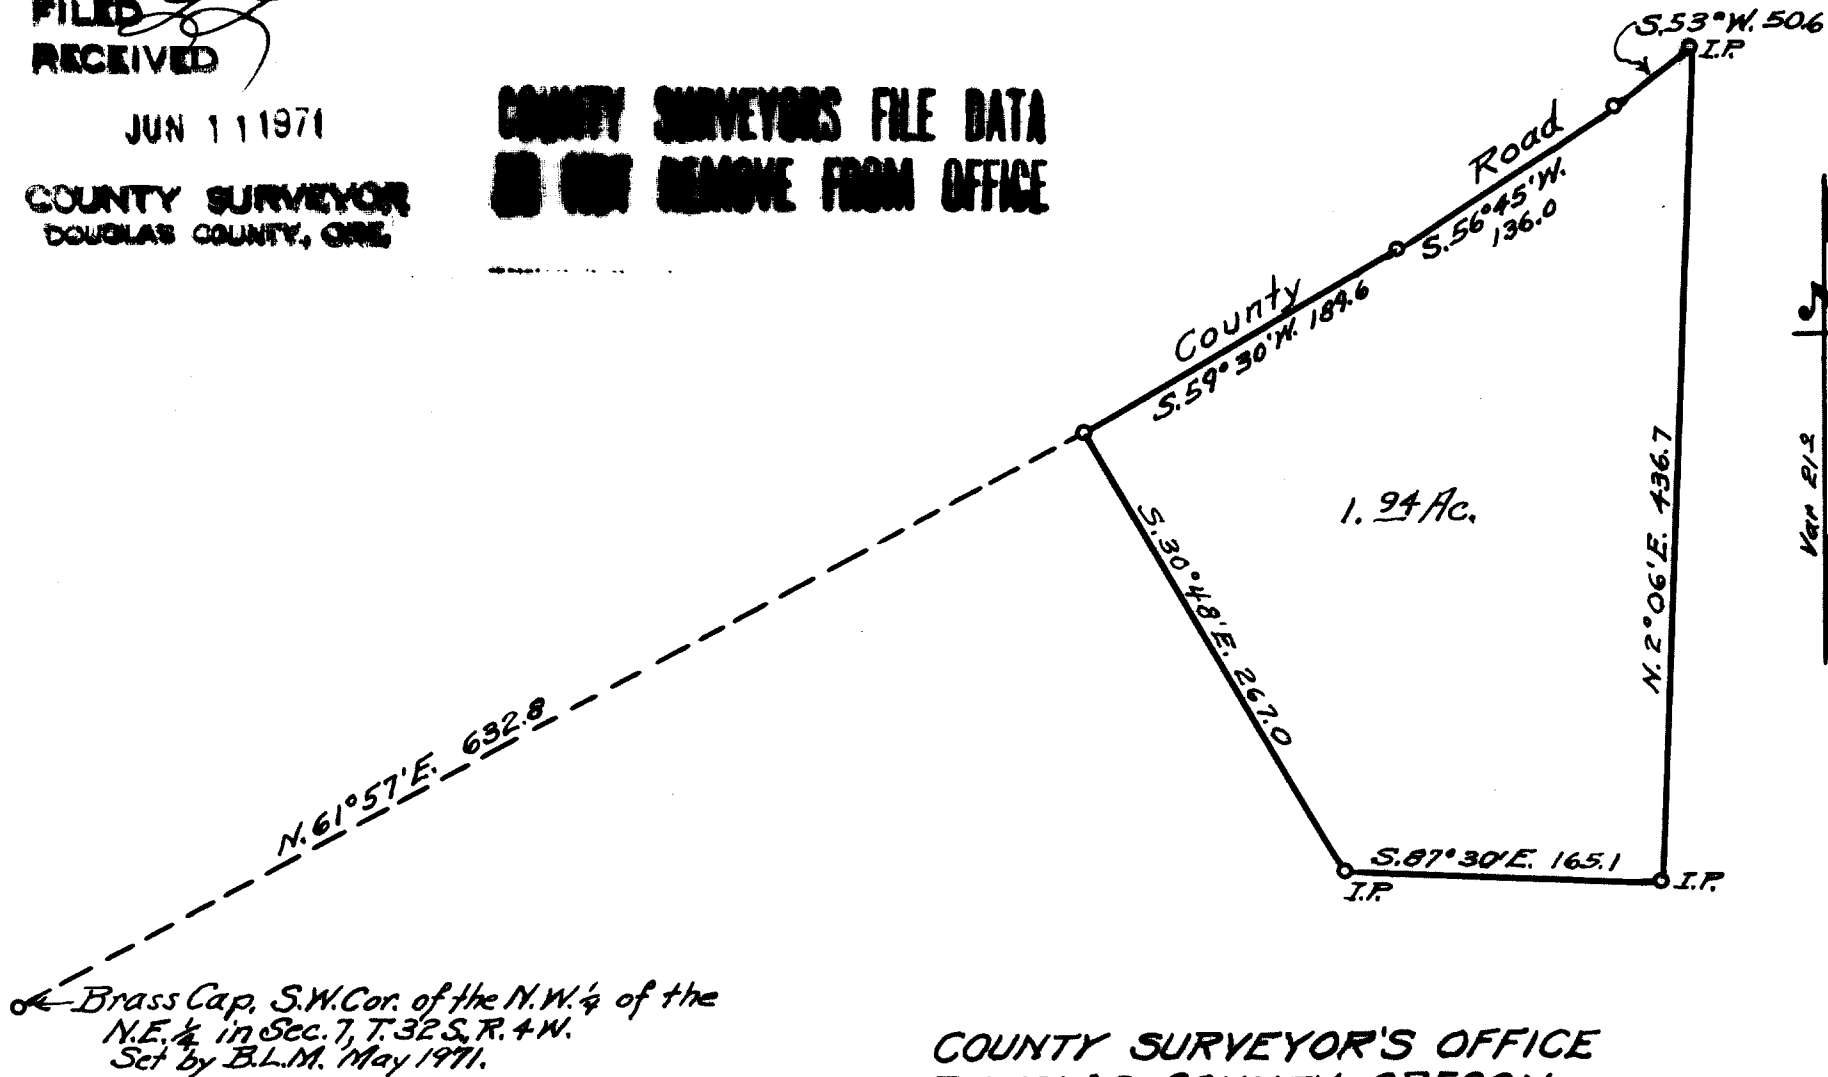

COUNTY SURVEYOR'S OFFICE  
DOUGLAS COUNTY, OREGON  
SURVEY FOR  
ORLO WORLEY IN SEC. 7, T. 32 S., R. 4 W.  
GEO. J. WENDEROTH, DEPUTY. JUNE 1971  
Scale 1" = 100ft.

REGISTERED  
OREGON  
LAND SURVEYOR

*Geo. J. Wenderoth*

MARCH 19, 1944  
George J. Wenderoth  
5