


(1A)

Point Set on Line


T 22 S R 12 W

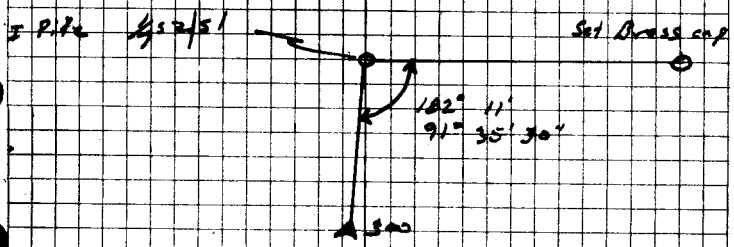

Set Brass cap at center sec line MSP,  
county surveyors office

T 22 S R 12 W

RM 1

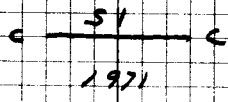

DIETZGEN NO. 388-6

Bearing Trees

20" D.F.V. scribbled RMA CC N 30 W 29 ±  
S 1 CS BT

27" D.F.V. scribbled RMA CC S 71 E 4 E  
S 1 CS BT

5-4-71  
J.W.H.

#107-122-12

Ref. Monument on E-W Center Line for CW 1/4

C.S. File No. 56/5-1