


car set

$\frac{31}{2} \mid \frac{32}{5}$

T215  
T225 P11W (12)

This car set from survey as follows

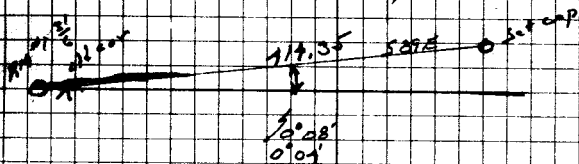

set Brass cap at same car MRP.

County Surveyors office

T215 R11W

$\frac{531}{56} \mid \frac{572}{55}$

T225  
1971

Also set steel fence post along side  
Brass cap

This car lies in large field  
south of Highway 58.

7-9-71

*[Handwritten signature]*

DIETZGEN NO. 385-6

#63-721-11  
#97-722-11

C.C.

C.S. File No. 56/5-2