


cor set

W.C.
1/4 2/1

T225 R12W

This cor set from survey as follows

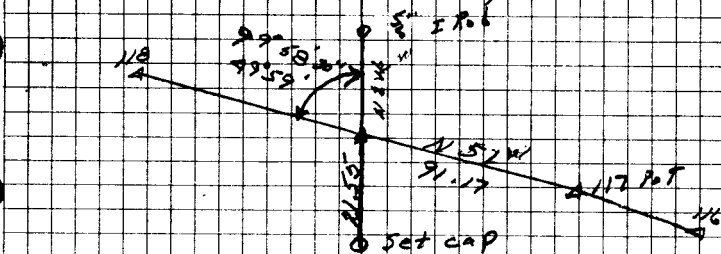

This with cor set on sec line of 2/1
M&D.

county surveyors office

7225 R12W

W.C. To

52/21

19 71

DIETZGEN NO. 388-6

Bearing objects

5"
8" I Rod

N49W

33°

This Rod 7³/₄ South of South Rail of R.R. Tracts

5"
8" I Rod

N2W

50°

This Rod 9³/₄ North of North Rail of R.R. Tracts

This Brass cap was 9⁸/₈ South of
South Rail of R.R. Tract
+ 364.99' N of VA CORNER

✓ #106-T22-12

C.S. File No. 56/5-3