


cor set

W.C. 536

T215 P12-174

13

This cor set from survey as follows

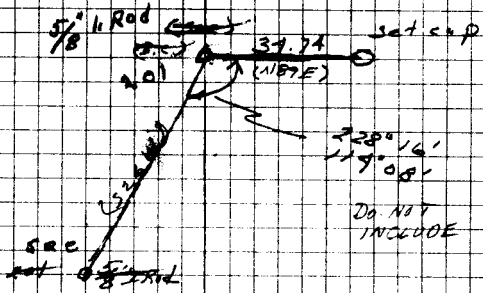

DO NOT INCLUDE DIAG.

Set Brass cap for W.C. corner MKR county Surveyors office

T215

R	12	W	536	1/4	R	14	W
---	----	---	-----	-----	---	----	---

1971

Bearing Tree + objects

17" Maple	varied	W.C.	N82E	CS BT	67°
-----------	--------	------	------	-------	-----

5/8" I Rod			N78E W		68°
------------	--	--	--------	--	-----

5/8" I Rod			S.89 W		74°
------------	--	--	--------	--	-----

Note: This cor line approx 6° south of Drive way

6-15-71

NO CORNER 250.24' N. 1/4 Cor. Sec 36 T21-12W

✓ #65-T21-11
#27-T21-12

56/5-4

DIETZGEN NO. 3865-6