


(4)

Renewal

$\frac{35}{2}$

T213  
T223 R12W

This cor set from survey as follows

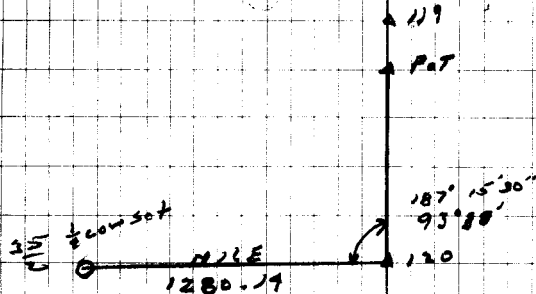

Renewal

Set Brass cap at  $\frac{1}{4}$  cor MKD  
County Surveyors office

T215 R12W

$\frac{1}{4} \frac{335}{32}$

T223  
1971

New Bearing Trees

13" Hemlock N53E 50<sup>2</sup>

scribed  $\frac{1}{4}$  S 35 CS BT

5" P. Fir S 21 W 49<sup>2</sup>

scribed  $\frac{1}{4}$  S 2 CS BT

Note: call of 2.50 chains East to  
break checks very good.

R  
✓ #30 T21-12  
✓ #96 T22-12

CS 54/5-6

9-22-71  
JMD