


⑤

Point on line set from survey T225 R12W

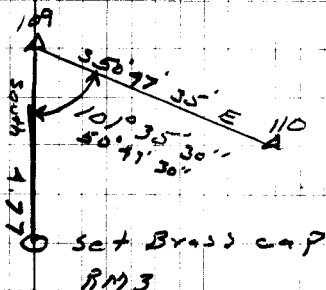

Set Brass cap at Point on line MKD,  
county Surveyors office

T225 R12W

RM3

51  
512  
1971

Bearing Trees

8" Hemlock S22E 4<sup>1</sup>/<sub>2</sub>  
Scribed RM3 512 CS BT

16" Hemlock N69<sup>1</sup>/<sub>2</sub>W 23<sup>5</sup>/<sub>8</sub>  
Scribed RM3 51 CS BT

Note:

This cor lies on top of small Ridge approx

75° West of Prairie Running about S70E.  
✓ RM 287.24' W. - W<sup>1</sup>/<sub>16</sub> corner 1412 CS/1K-7 5-9-71 90%