


5 1/2
 Dear Set Brass Survey 52/51 7225 R12 W

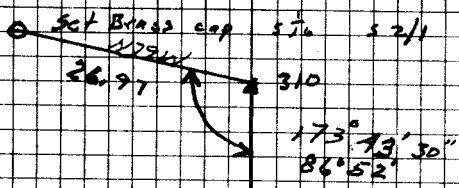

1
Set Brass cap MKD.

County Surveyors Office
7225 R12 W

5 1/2
 52 51
 1971

DIETZGEN NO. 385-B

New Bearing Trees

8" Hemlock 519E 11"
scribed 5 1/2 51 55 BT

10" Hemlock 550W 13"
scribed 5 1/2 52 55 BT

Note:
This cor lies approx 25° North
of ridge Top, Ridge Runs E-W.

5-9-71
J. T. G.

R

✓ 1988

c.s. 56/5-8