


cap set

W.C. W 1/16
S 11

T225 R12W

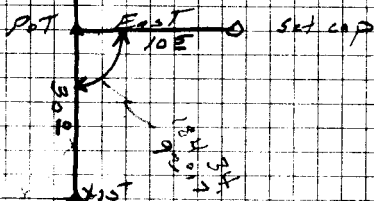

X old cap

set Brass cap for W.C. 1950

county Surveyors office

T225 R12W

W 1/16

S 11

W.C.

1971

Bearing Trees:

39' Spruce scribed	W.C.	S22W W 1/2 S 1 CS BT	C 1 E
28' Spruce scribed	W.C.	S36W W 1/4 S 1 CS BT	S 7 C

W.C. W 1/16 S 1
S 12

✓ #. 78

C.S. File No. 5615 6-N-21
-11