


cor set from survey

36

7215
7225 R12W (5)

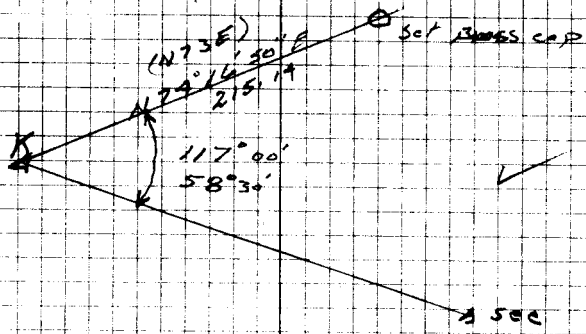

Set Brass cap at 1/4 cor 12120.
county Surveyors office

7215 R12W

$\frac{1}{4} \times 36$
 9
 7225
 1971

Also set steel Fence Post along side

Bearing Tree

18" Horn post 576 ml 81°
 Scribed 1/4 S1 CS BT

Note: This cor lies on top of very steep drop off to the westerly bank of Kimpou River

6-10-71
 J. M. G.
 J. M. G.
 J. M. G.
 J. M. G.

✓ 11-T21-11W
 ✓ 22-T22-11W

56/5-14

DIETZGEN NO. 385-6