


cor set

51)

7225 152-11W

6

This cor set from survey as follows

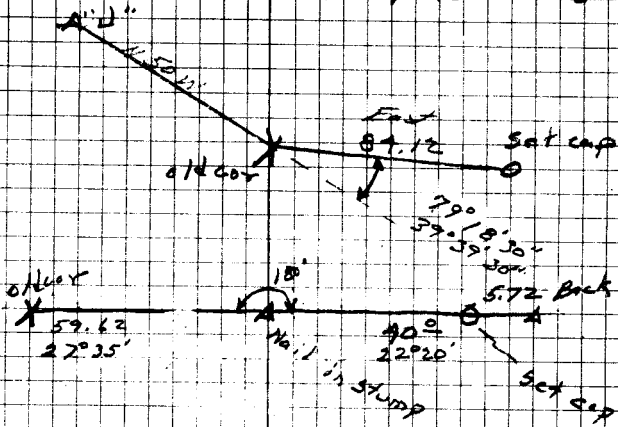

Set Brass cap at Yakor MKD
county surveyors office

7225
 R 12 51 1/4 11
 W W
 1971

Bearing Tracs

5" Hemlock	N 10 W	49 3
scribed	1/4 51 CS BT	
18" Hemlock	N 90 E	11 3
scribed	1/4 5 CS BT	

#105-722-11

#80-722-12

over

C.S. File No. 5615

7-9-71
 MKD
 [Signature]
 15

DIETZGEN NO. 385-6