


cor set

16 ONLY T 225 P 11W

This cor set from survey as follows

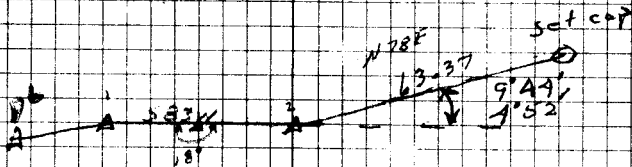

Set Brass cap at $\frac{1}{4}$ cor MND

county Surveyors office

T225

R	12	1/4	56	11
W			1971	W

Bearing Tree

80' cedar

SBOW

63'

Scribed

$\frac{1}{4}$ 56

CS BT

No other Trees Available

Note: This cor lies in bottom of Ravine, Ravine runs N-S

C.S. File No.

56/5-16

✓ #106-T22-11
81-T22-12

over

7-9-71
T225
11W
1971