


car set

$\frac{37}{57}$

T215
T225 P11W

This car set from survey as follows.

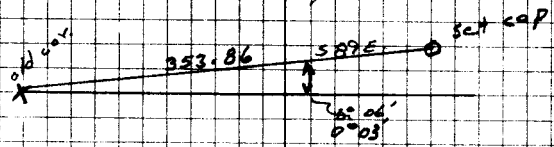

Set Brass cap at 1/4 cor MK2
county surveyors office

T215 P11W

$$\frac{1}{4} \frac{532}{55}$$

T225
1971

DIETZGEN NO. 385-6

Also set steel fence post along side
Brass cap.

7-9-71

[Handwritten signature]

✓
* 68-T21-11W
#101-T22-11

C.S. File No. 56/5* ^A