


cor set

12/6

7225 R12-11W

11

This cor set as follows from survey

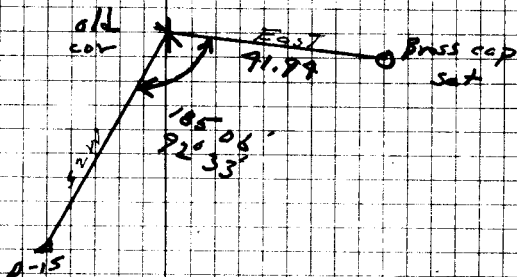

Set Brass cap at sec cor MAD
county Surveyors office

7225

R	51	R
12	512	11
W		W

1921

DIETZSEN NO. 385-6

Bearing Trees

14" Maple
Scribed 7225 West R12W S1 CS BT A15

10" D.F.Y
Scribed 7225 N72E R11W S6 CS BT 24B

14" D.F.Y
Scribed 7225 S40W R12W S12 CS BT 60B

Note: This cor lies in bottom of
ravine, turning N&S

#99
22-11
#83-722-12

6-8-21
J.W.C.
7-3-21
5615-19

U.S. File No.