


Cor Set

$\frac{33}{7}$

T 213 (10)
T 223 R 11W

This cor set from survey as follows

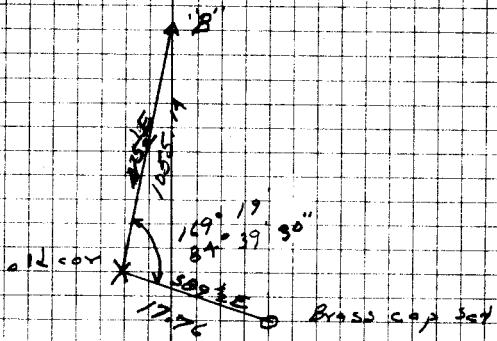

DIETZGEN NO. 385-6

This cor set + Brass cap MKD,
county surveyors office
T 213 R 11W

$\frac{33}{7}$

T 223

1971

Also set steel fence along side of Brass cap
bearing objects:

$\frac{5}{8}$ " I Rod N 89 W 42 2

$\frac{5}{8}$ " I Rod N 89 E 9 3
This I Rod Base of stump at setting on Rock

No Traces available for B.T.S.

Note: This cor lies on steep ridge top,
Ridge runs N 45 E. Also creek bears East
approx 195 E.

G.B. 71
J.P. 72
W.P. 73

#71 - T 21 - 11W
#103 T 22 - 11

U.S. ... 56/5 - 20