


Cor set

12 | 56  
57

T225 R12-11W

11

Cor set as follows from survey

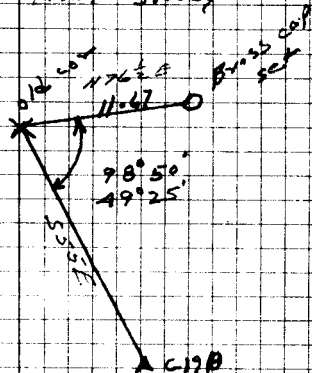

Brass cap set at this cor MND  
county surveyors office

225

cc

|   |    |    |    |   |
|---|----|----|----|---|
| R | 12 | 56 | 57 | R |
| W | 12 | 56 | 57 | W |

1971

BERRING T500

15" Fildon

S 12 W

15"

Scribed T225 R12W S 12 CS BT

8" Fildon

S 20 E

17"

Scribed T225 R12W S 20 CS BT

1/8" Rod

N 96 E

30"

This Rod lies on westerly Edge of Marsby ground.

✓ 107-T22-11W

0.84-T22-12W

C.S. File 100

6-8-71  
56/5-110-2  
J/S

DIETZGEN NO. 385-6