

1-12-73

- NOT FOUND -

N.W. COR. D&C 43 T295 R6W1

Found AXE AT old Fence cor

as noted on card (INCON)

searched for BX6 stone with no results.

1/4 COR 35/36 T295 R6W1

Renewal # 22 -

I find stake at APPROX COR

NO Trace of Bearing Tree

S 71 1/2 W 363°

stake at APPROX 1/4 COR probably

set By (INCON)

a.k.

NOTE SOMETHING FOUND,
BUT CORNER NOT RENEWED.


C.S. File No. 56/25-5

DIETZGEN NO. 3885-B

NW. COR. D.L.C. #43

Section 35-36 Twp 24 S Rge 6 W

Date: 3-29-70

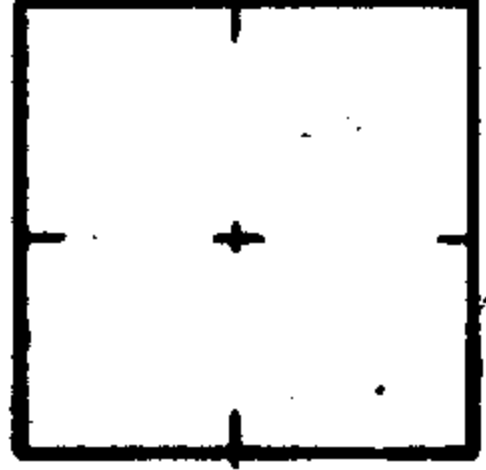

How was corner identified? AXEL

(COR 3 470)

Condition of corner: GOOD

JOHN

Best route to reach corner: GREEN VALLEY ROAD

EAST SIDE OF ROAD IN FENCE CORNER

Other Remarks:

Quadrant	NE	NW	SE	SW
Species & Size				
Dist. & Bearing				
Condition of Scribe				
Original or Resurvey				
Appearance of B.T.				
Tags, Marks, etc.				C.S. No. 56/25-5 INCON

[Signature]

Signed

672-5270