

Renew M.C. $\frac{519}{530}$ T22S R12W

at point for most easterly M.C.
Fd. $\frac{3}{4}$ " I.P. set by Menasha in
March 1973 & O.B.T.s as follows -
orig. 8" now 16" Cedar S, 57° E, 11⁹ft,
previously opened no scribe fd.
Blaze decayed - we Rescribe
"M.C. T22S R12W 530 CS BT" along
side old Blaze.
orig. 30" now 36" Fir N, 14° W, 19⁸ft.
shows "BT" SCAR - unopened & BARK
scribe "T22 S" we Rescribe
"MC T22S R12W 519 CS BT" alongside
old scribe - we do not set
BRASS cap - $\frac{3}{4}$ " I.P. set for cor.
Lies about 6 ft. from water's
edge.

August 16, 1973

V.R.T.
J.G.H.
Jerry M. Isgro
(LAND Dept.)


OK J.G.H.

107

C.S. File No. 56/35-1

N.F. T22S R12W

M.C. $\frac{519}{530}$ see sketch

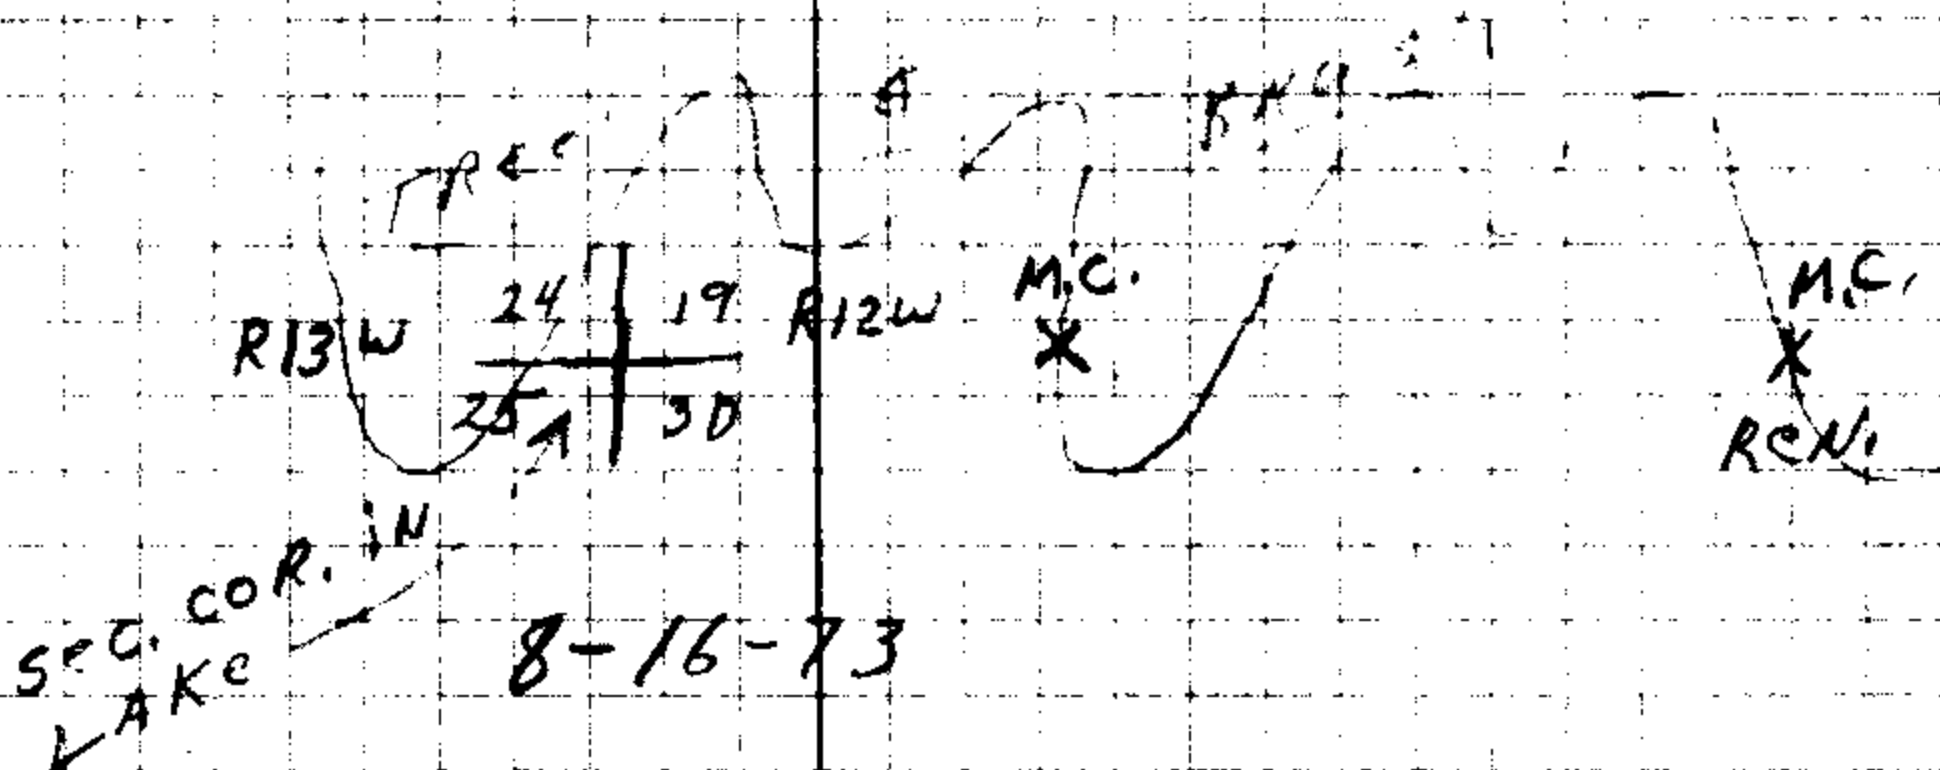

✓ N.F. $\frac{1}{4}$ COR $\frac{519}{530}$ NO ALDERS IN

THE TREES ARE OLD ENOUGH OR
LARGE ENOUGH TO HAVE BEE 15"
DIAMETER IN 1891

8-16-73

✓ N.F. MOST NORTH M.C. OF R13W S25 $\frac{530}{530}$ R12W

Fd. OLD UPROOT SPRUCE - CRAWLED
UNDERNEATH - COULD NOT SEE
SCRIBE OR SCAR - WE WOULD NOT BE
ABLE TO DETERMINE EXACTLY WHERE
TREE STOOD, IF IT IS THE BIT
CALLED FOR -

8-16-73 Reverted
10/11/73

DIETZGEN JUN 5 1973