

6-14-74

NE CORNER DLC 43 T27S R7W

(SEE REV'S # 51, 116, 136 & 138.)

ALSO RM 1-24 & M20-33

FD:

$\frac{3}{4}$ " IRON ROD DRIVEN FLUSH WITH THE
PAVEMENT AT THE APPROX. CENTERLINE
OF "ORCHARD LANE", COUNTY RD # 253

FD:

BRASS CAP SET NEAR SOUTHERLY
RIGHT OF WAY FENCE OF ORCHARD
LANE MARKED

COUNTY SURVEYOR'S OFFICE

W. COR

DLC 43 NE COR

T27S R7W

15' NORTH TO COR.

#182 ✓

C.S. FILE NO. 57/51-24 c

PAGE 1

FROM WHICH:

20" NOW 22" W. OAK BEARS S 23° W

68⁵ FT., SCRIBING VISIBLE ON UNHEALED
BLAZE.

8" NOW 10" W. OAK BEARS S 18° E


57² FT., WELL-HEALED.

WE REMOVE MARKING FROM THE BRASS
CAP AT THE WITNESS CORNER AND
REMARK IT TO READ:

COUNTY SURVEYOR'S OFFICE

T275 R7W

WIT. COR

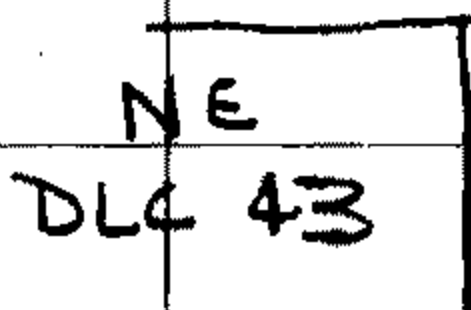

N 48° 26' W 40.75 FT.

TO COR.

1974

SET STEEL FENCEPOST ALONGSIDE BRASS CAP.

DIETZGEN NO. 385-5


C.S. File No. 56/65/21

NOTE:

BEARING AND DISTANCE AS SHOWN
ON BRASS CAP IS TAKEN FROM
A SURVEY BY G.R. LECKLIDER, MARCH,
1961, RECORDED N 20-33.

6-14-74

Mary Langley
PETER L. EARLE

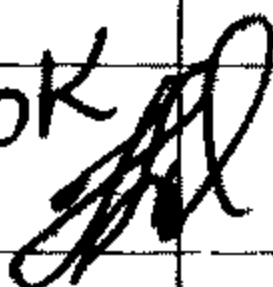OK 

DIETZGEN NO. 385 - 5