

7-29-74

7285

35

2

$\frac{1}{4}$  R I E

7295

FD:

1" IRON PIPE WITH BRASS CAP

ATTACHED, MARKED:

U.S. GENERAL LAND OFFICE SURVEY

$\frac{1}{4}$

535

52

1921

LEANING AND LOOSELY SUPPORTED

IN A MOUND OF ROCKS. DUE TO

INCONSISTENCIES FOUND IN THE

MEASUREMENTS FROM THE BRASS

CAP AT ITS PRESENT LOCATION AND

THE FACT THAT THE MOUND OF ROCKS

IS NOT MENTIONED IN THE ORIGINAL

FIELD NOTES, WE REMOVE THE

PAGE 1

G. S. File No. 57/2-6

C

DIETZGEN NO. 385-1-5

70 729-1E ✓  
#3-7281E ✓

NEW NW

N 50<sup>1</sup>/<sub>4</sub>° W

14" D Fir

29<sup>6</sup> - @ 18° .9511

28<sup>2</sup>

" 1/4 S 35 CS BT "

NEW SW ~~989~~ D. Fir

S 13<sup>1</sup>/<sub>2</sub>° W

27° LUL

" 1/4 S 2 CS BT "

BRASS CAP AND RESET IT AT THE  
FOLLOWING MEASUREMENTS FROM THE  
REMAINS OF THE TWO ORIGINAL  
BEARING TREES;

AN ORIG. 30' FIR, NOW A 36" FIR SNAG  
BEARS N 4°E 16<sup>5</sup>/<sub>16</sub> FT., WE OPEN  
AND FIND GOOD SCRIBING "5" ON A  
ROTTEN FACE.

AN ORIG 7" NOW 9" MADRONE  
BEARS N 83°E 7<sup>3</sup>/<sub>16</sub> FT., (REC. S 83°E  
7<sup>3</sup>/<sub>16</sub> FT.). WE FIND SOME ILLEGIBLE  
SCRIBE MARKS ON AN OPEN BLAZE  
THAT HAS BEEN DEFACED SOME YEARS  
EARLIER.

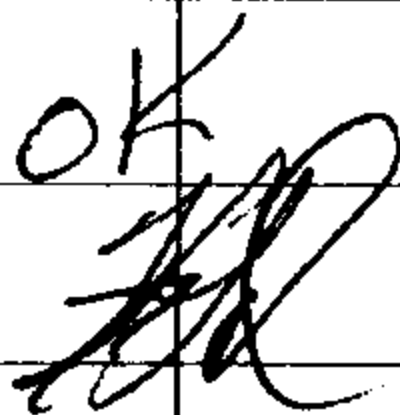
THE BRASS CAP IS NOW SET 16"  
 IN THE GROUND TO SOLID ROCK AND  
 SUPPORTED BY A MOUND OF STONE  
 2 FT. WIDE BY 1 FT. HIGH, FROM  
 WHICH WE MARK THE FOLLOWING  
BEARING TREES;

A 14" D. FIR BEARS N 50° W 28 ± FT.,  
 SCRIBED "1/4 S 35 CSBT"

A 9" D. FIR BEARS S 13 1/2° W  
 27° FT., SCRIBED "1/4 S 2 CSBT"

7-29-74

Nancy Langley  
 PETER L. EARLE

OK  


DIETZGEN NO. 385-5