

8-27-74

22/23  
27/26 T295 R1E

FO:

A 12" X 12" X 8" CONGLOMERATE STONE,  
(REC. 15" X 12" X 8") FIRMLY SET IN MINERAL  
SOIL AND BURIED UNDER FOREST DUFF, MARKED  
WITH A "+" ON TOP AND 2 NOTCHES EACH  
ON THE SOUTH AND EAST FACES;

FROM WIKH:

AN ORIG. 18" NOW 20" GRAND FIR BEARS  
N 57° E 50<sup>±</sup> FT., (REC. N 40° E 44<sup>±</sup> FT.),  
ALIVE AND WELL-HEALED SHOWING A  
GOOD SCAR.

AN ORIG. 16" NOW 22" GRAND FIR BEARS  
S 89° E 43<sup>±</sup> FT., ALIVE AND WELL-  
HEALED BUT SHOWING SIGNS OF ROT  
AT THE BASE.

AN ORIG. 36" NOW 48" D FIR BEARS S 59° W  
57<sup>±</sup> FT., ALIVE AND WELL-HEALED SHOWING  
A GOOD SCAR.

#75 ✓

C. S. File No. 57/2-16 Page 1c

TO OBT NW

55<sup>2</sup>@ 11° 9816 54<sup>2</sup>

TO OBT SW

D. FIR

57<sup>5</sup>@ 6° .9945 57<sup>2</sup>

~~43<sup>6</sup>~~ 20" 22" G. FIR

~~43<sup>4</sup>@ 9°~~ .9877 ~~42<sup>9</sup> 43<sup>4</sup>~~

OBT NE 20" G. FIR

N 57° E

50<sup>0</sup> FT. LVL

~~NEW NW BT 10" D FIR~~

~~N 89<sup>1</sup>/<sub>2</sub>° W~~

~~25<sup>1</sup> LVL~~

~~T 29<sup>3</sup> R 1 E 522 CS BT~~

AN ORIG. 15" FIR, NOW DOWN AND WELL-ROTTED  
 BEARS N 13° W 54  $\frac{8}{16}$  FT. WE FIND  
 FRAGMENTS OF THE ORIG. BLAZE AND  
 ILLEGIBLE SCRIBE MARKS.

THIS CORNER LIES APPROX. 30 FT. SOUTH OF  
 A SMALL STREAM.

AT THE CORNER POINT, WE SET A 1" IRON PIPE  
 WITH BRASS CAP ATTACHED, MARKED,

COUNTY SURVEYOR'S OFFICE

T 29 S

S 22 | S 23

S 27 | S 26

R 1 E

1974

FLUSH WITH THE GROUND. WE PLACE THE  
 ORIGINAL STONE ALONGSIDE AND MARK  
 THE FOLLOWING BEARING TREES:

A 10" D. FIR BEARS N 89  $\frac{1}{2}$ ° W 25  $\frac{1}{2}$  FT.,  
 SCRIBED "T 29 S R 1 E S 22 CS BT"

NEW SE BT

10 "D FIR

S  $10\frac{1}{2}^{\circ}$  E

26<sup>4</sup> @  $23^{\circ}$  9205

26<sup>1</sup>

T295 R1E S26 CS BT

NEW NE BT

12 " HEMLOCK

~~S  $10\frac{1}{2}^{\circ}$  E~~

N  $82^{\circ}$  E

36<sup>7</sup> @  $6^{\circ}$  9945

36<sup>5</sup>

T295 R1E S23 CS BT

A 10" D. FIR BEARS S 10 1/2° E 26 1/2 FT.,  
SCRIBED "T29S R1E S26 CSBT".

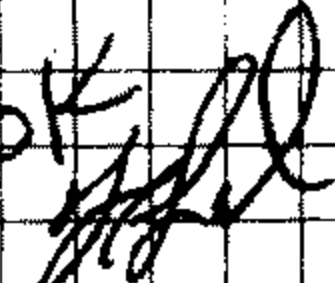
A 12" HEMLOCK BEARS N 82° E 36 5/8 FT.,  
SCRIBED "T29S R1E S23 CSBT".

NOTE! COMPASS DECLINATION SET AT 20° EAST.

8-27-74

Larry Langley

PETER EARLE

OK 

DIETZGEN NO. 385-6