

RESTORED CORNER FOR STATE OF OREGON-DEPARTMENT OF FORESTRY

Section corner common to Sections 25 and 36 (West end), Township 22 South, Range 12 West, W.M., Douglas County, Oregon.

ORIGINAL

Fir Post (Found in place, badly decayed with one notch on South Side) from which a:

- 14" Fir bears S28°E 28 lks.; now 27", in place, scribe S exposed.
- 9" Alder bears N77°E 9 lks.; missing.

RESTORED

Set 1 1/2" X 36" galvanized iron pipe with 3" bronze cap marked "OREGON STATE BOARD OF FORESTRY S35 T22S S25 S36 R12W 1974 RS359", 34 inches in ground, and from which a:


- 29" Fir bears N53°E 98.4 ft. to face; scribed T22S R12W S25 BT RS359.

Set 4" X 4" X 72" white painted Cedar post 4.3 ft. N7°W of corner pipe. Oregon State Forestry Department metal location poster on 40" Fir N9°W 11.7 ft.

Dated June 17, 1974

Restored by William E. Metcalf, Engineer under my direction.

Present and witnessed by Anthony J. Klosterman
James L. Shumway
Donald E. Matlick

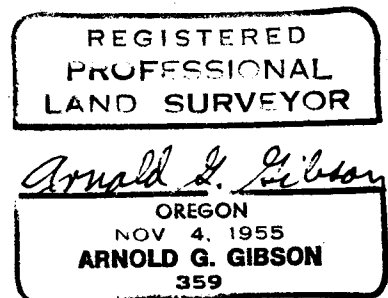

#45 722-12 ✓